


T. 9 S. R. 6 W. W.M.

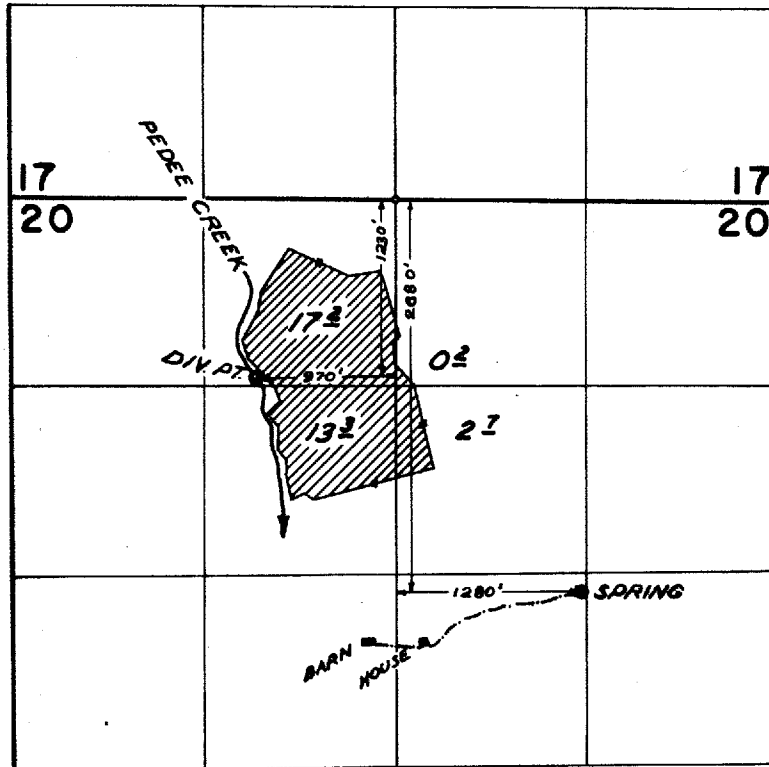

FINAL PROOF SURVEY UNDER

Application No. 39678 Permit No. 29620
IN NAME OF

CECIL H. JACKETS

Surveyed Aug. 5-6, 1965, by C. GARDNER