


T.7S

R.6W.

W.M.

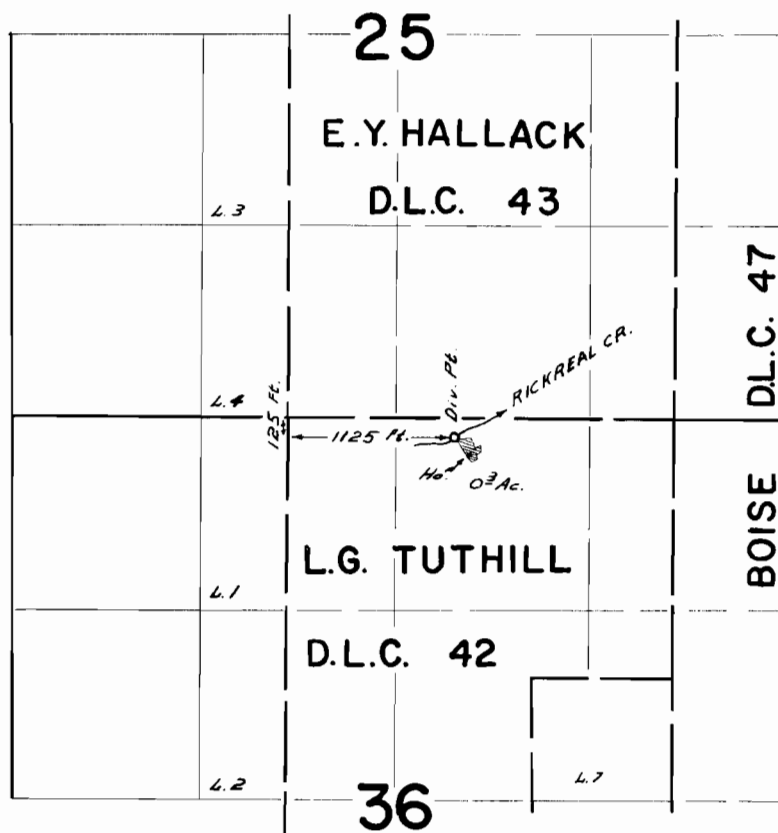

**FINAL PROOF SURVEY**  
UNDER

Application No. 37132 Permit No. 27626  
IN NAME OF

PER RICHARD KARLSEN

Surveyed JULY 28 1965, by C. GARDNER