


T. 7 & 8 S. R. 5 W. W.M.

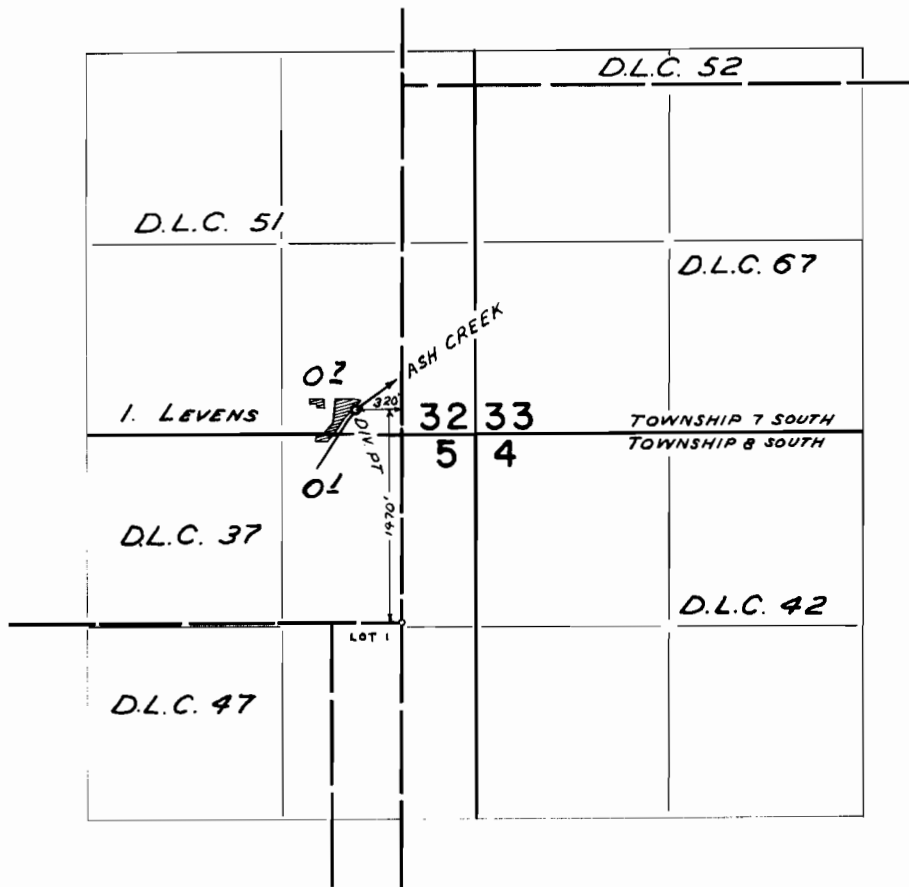

FINAL PROOF SURVEY UNDER

Application No. 37719 Permit No. 28012
IN NAME OF

Willis W. Keller

Surveyed JUL 29 1965, by C. GARDNER