


T. 6 S. R. 3 W. W.M.

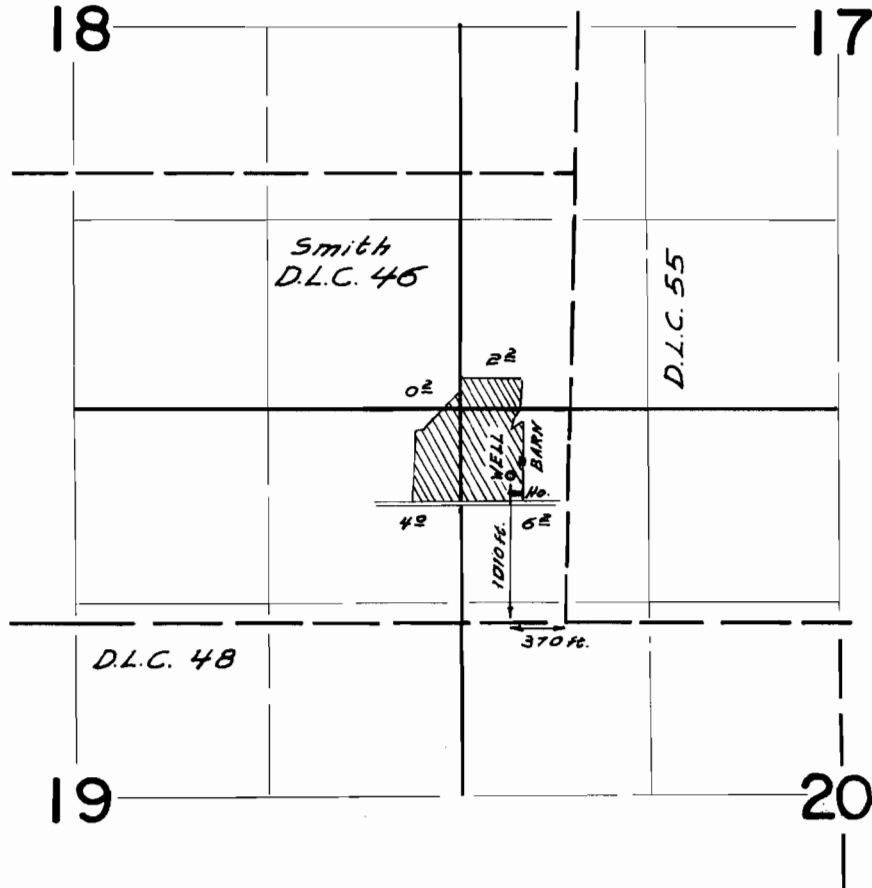

FINAL PROOF SURVEY
UNDER

Application No. G-2404 Permit No. G-2213
IN NAME OF

Virgil R. Punzel

Surveyed July 30 1965, by C. Gardner