


T.8S. R.5W. W.M.

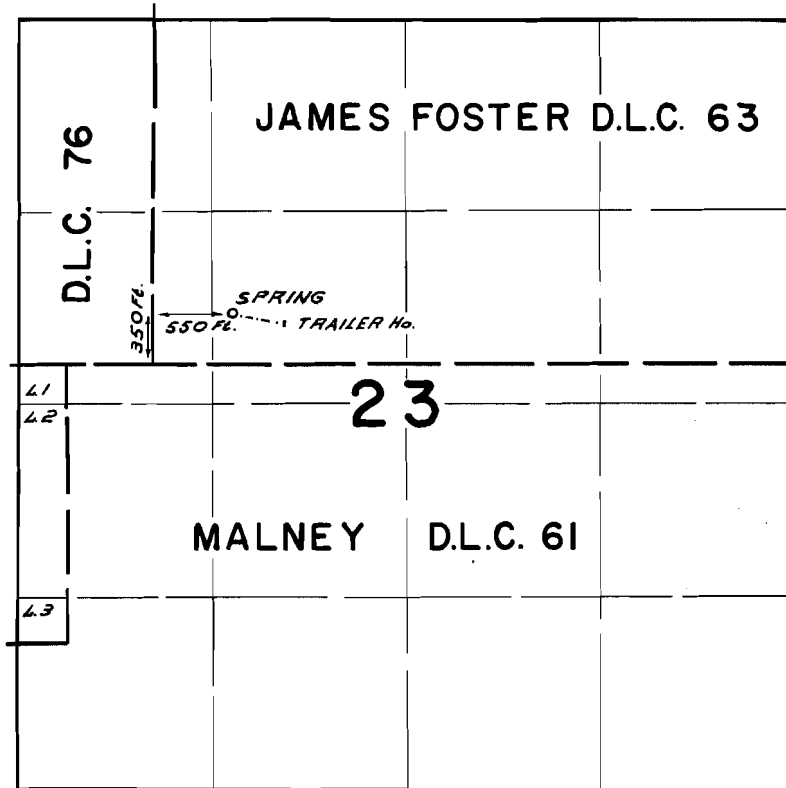

FINAL PROOF SURVEY
UNDER

Application No. 40579 Permit No. 30234
IN NAME OF

WILMA E. RODGERS

Surveyed AUG. 6 1965, by C. GARDNER.