


T. 9 S. R. 4 W. W.M.

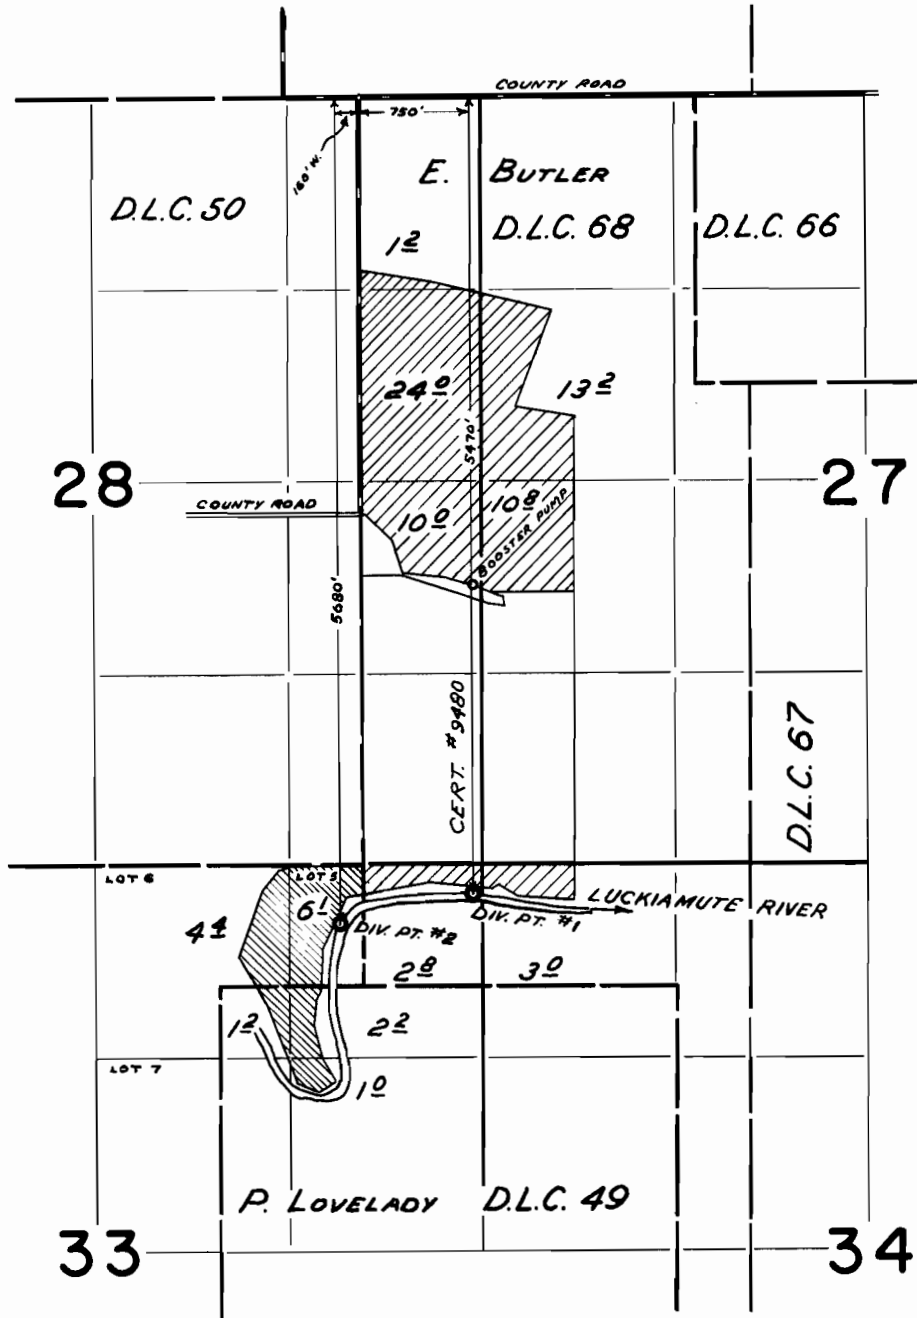

FINAL PROOF SURVEY
UNDER

Application No. 37265 Permit No. 27763
IN NAME OF

Warner & Linn

Surveyed Aug 17 1965, by C. GARDNER