


# T.3S.R.38E.W.M.

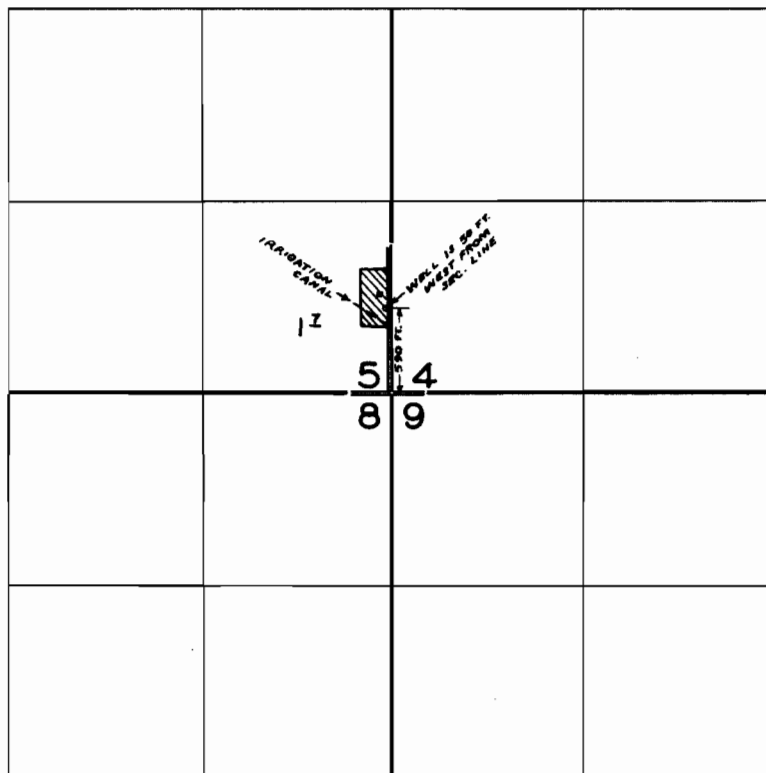

## FINAL PROOF SURVEY UNDER

Application No. G-2754 Permit No. G-2559  
IN NAME OF

EARL M. CONNELL

Surveyed Nov. 4 1965, by C. GARDNER