


T. 2 S. R. 12 E. W. M.

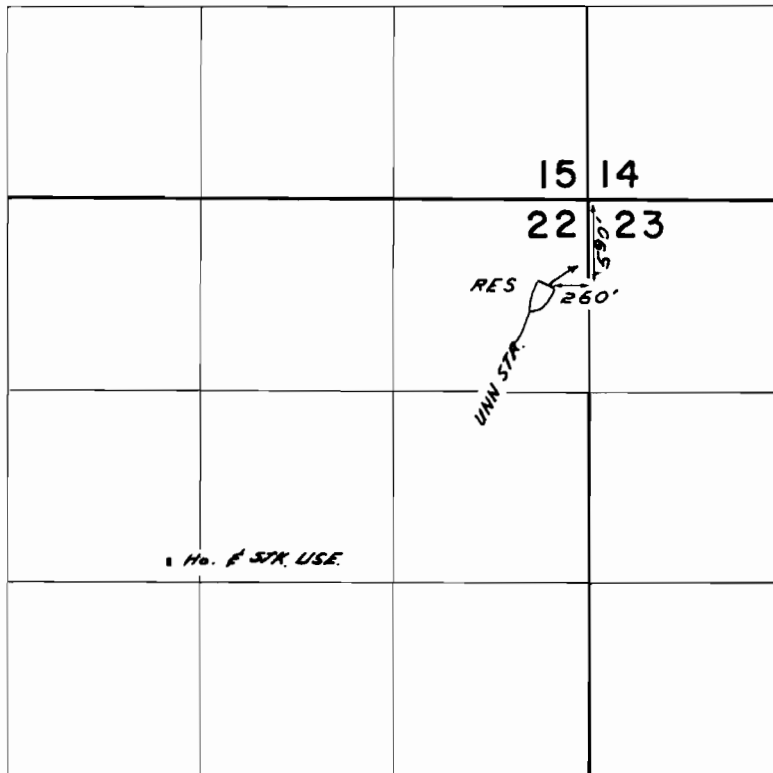

**FINAL PROOF SURVEY**  
UNDER

36597

27639

Application No. R-36596 Permit No. R-2687  
IN NAME OF

KENNETH SPENCER

Surveyed JUNE 10 1965, by C. GARDNER