


T.3S. R.2&3W. W.M.

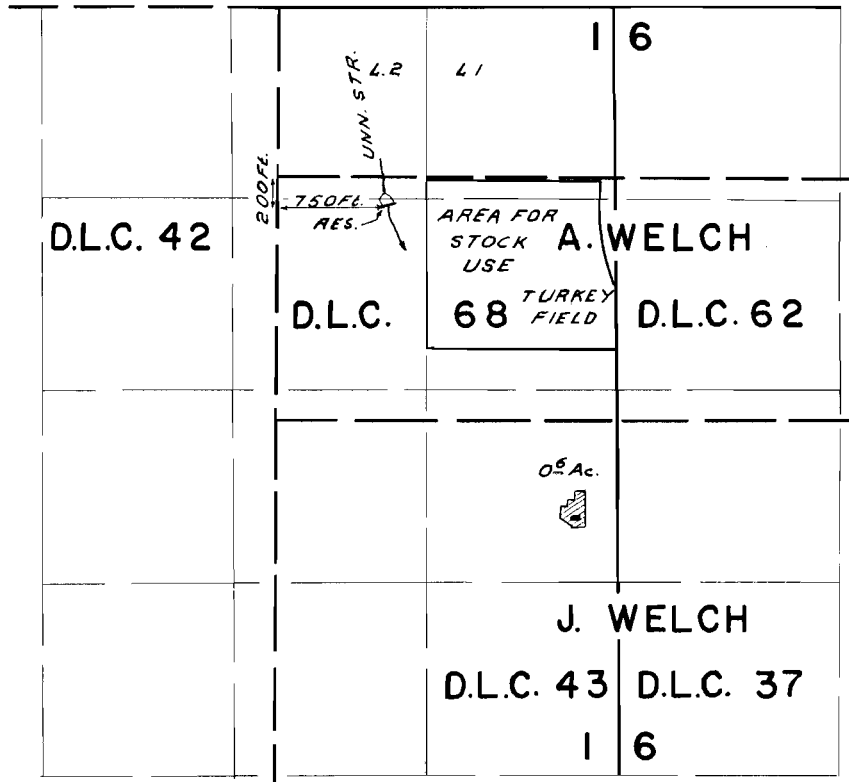

**FINAL PROOF SURVEY**  
UNDER

R - 37059                      R - 2663

Application No. 37060 Permit No. 27573  
IN NAME OF

RALPH E. JOHNSON

Surveyed AUG 19 1965, by L. COLEBANK