


T. 3 S. R. 5 W. W.M.

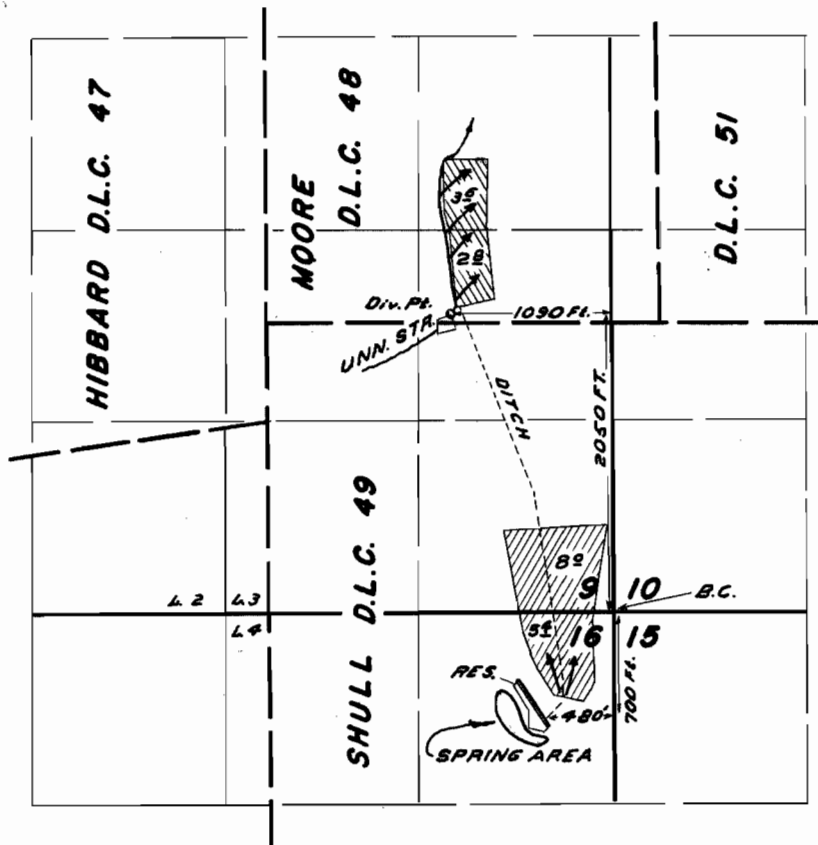

FINAL PROOF SURVEY

UNDER

R-37129

R-2629

Application No. 37130 Permit No. 27663

IN NAME OF

W. & R. WIRTH

Surveyed AUG 5 1965, by L. COLEBANK