


T. 3 S. R. 5 W. W.M.

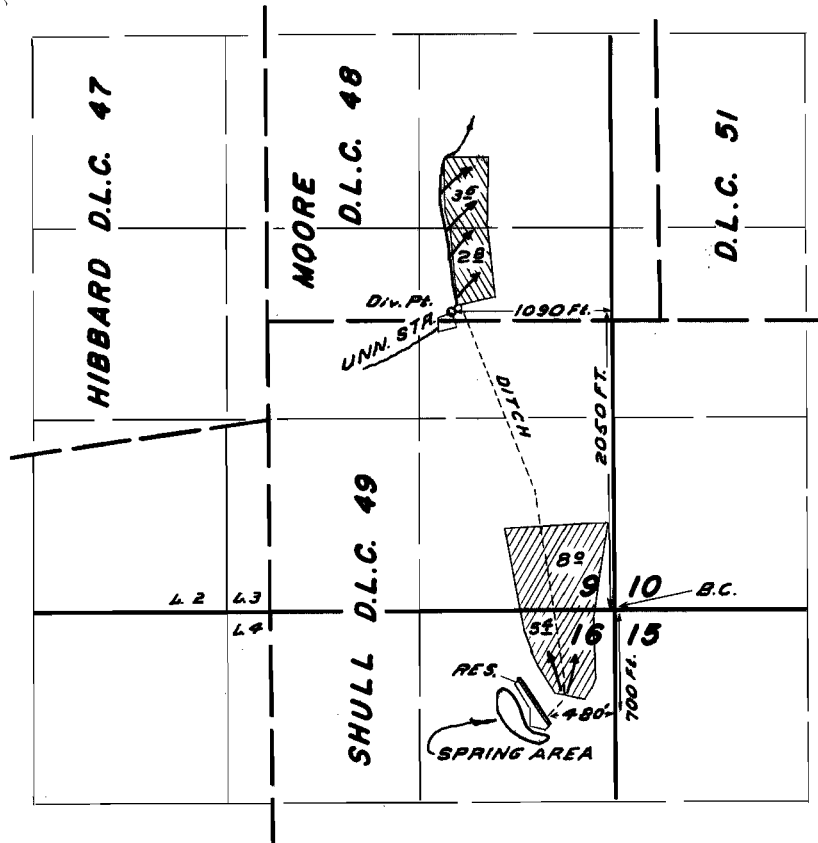

**FINAL PROOF SURVEY**  
UNDER

R-37129 R-2629

Application No. 37130 Permit No. 27663  
IN NAME OF

W. & R. WIRTH

Surveyed AUG 5 1965, by L. COLEBANK