


T. 3 S. R. 5 W. W. M.

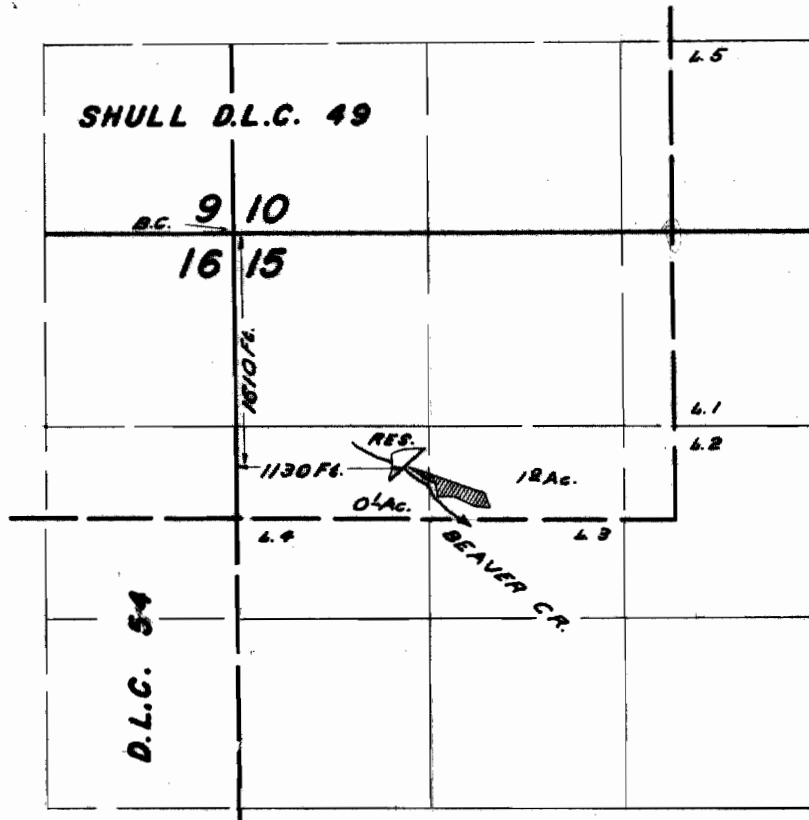

FINAL PROOF SURVEY
UNDER

R-37136

R-2697

Application No. 37137 Permit No. 27667
IN NAME OF

W. & R. WIRTH

Surveyed AUG. 5 1965, by L. COLEBANK