


T.4S.R.1E.W.M.

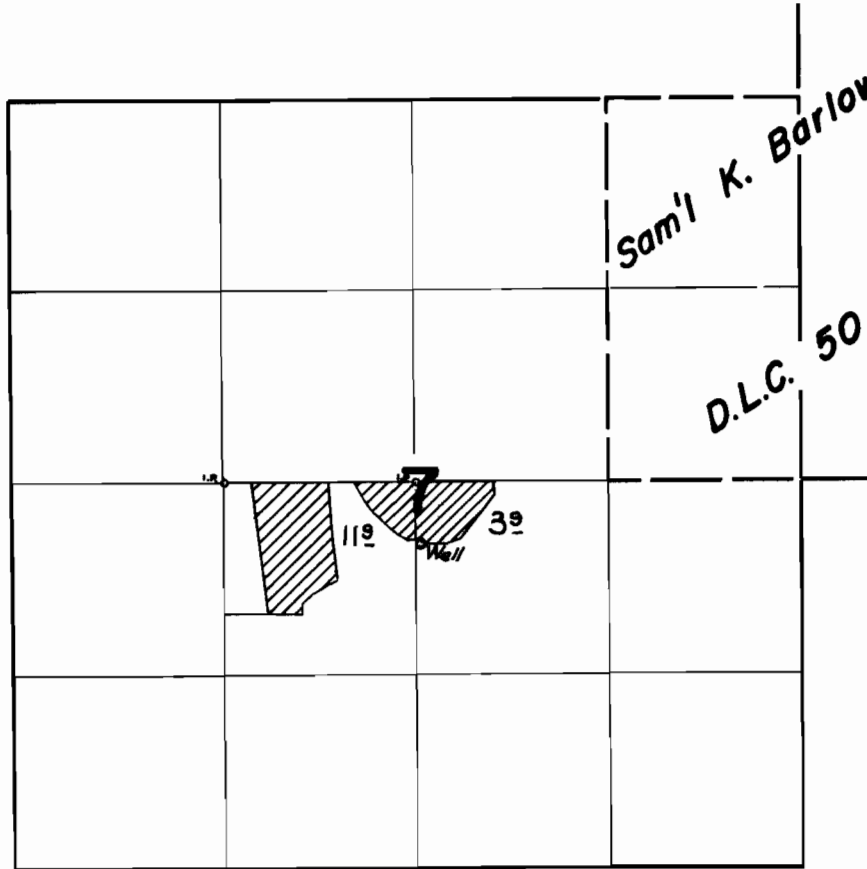

FINAL PROOF SURVEY UNDER

Application No. G-973... Permit No. G-820...
IN NAME OF

VICTOR HANAUSKA

Surveyed May 28 1963, by

[Signature]