


T. 6 S. R. 3 W. W. M.

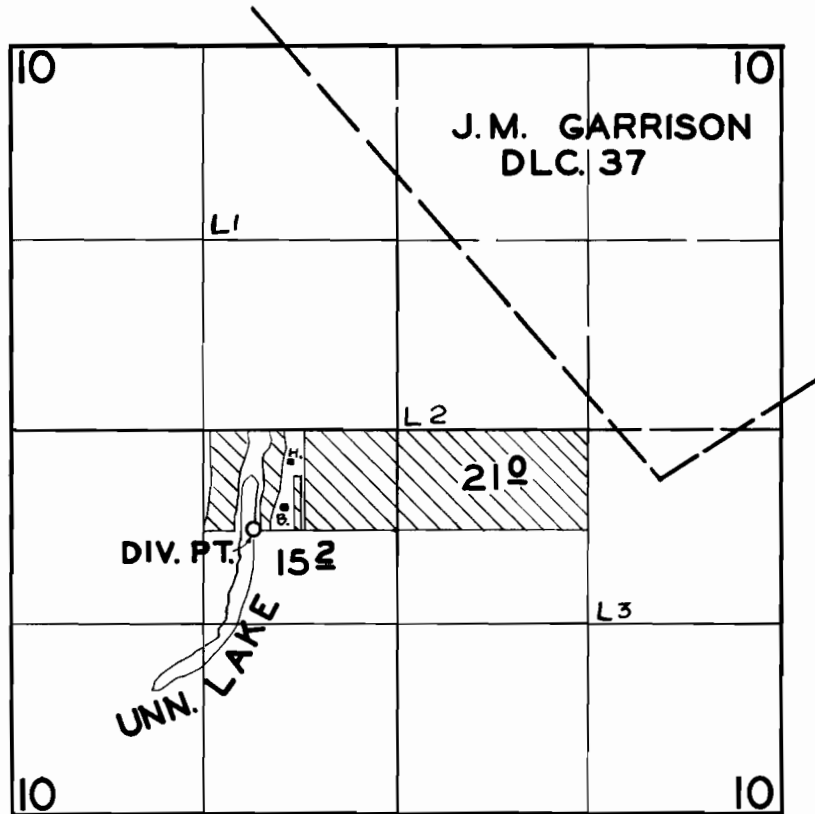

FINAL PROOF SURVEY
UNDER

Application No. **20947** Permit No. **16403**
IN NAME OF

DON H. WALL

Surveyed **3 JULY 1956**, by **M. BISH**