



# FINAL PROOF SURVEY


UNDER  
Application No. U-623 Permit No. U-582  
U-786 U-697

IN NAME OF  
W. H. & Pearl Woodruff  
Surveyed Aug. 19 1959, by C. O. Bartels


DVD-3M-67

Application No. U-623   
Application No. U-786 

T. 3 S. R. 39 E.  
T. 4 S. R. 39 E.

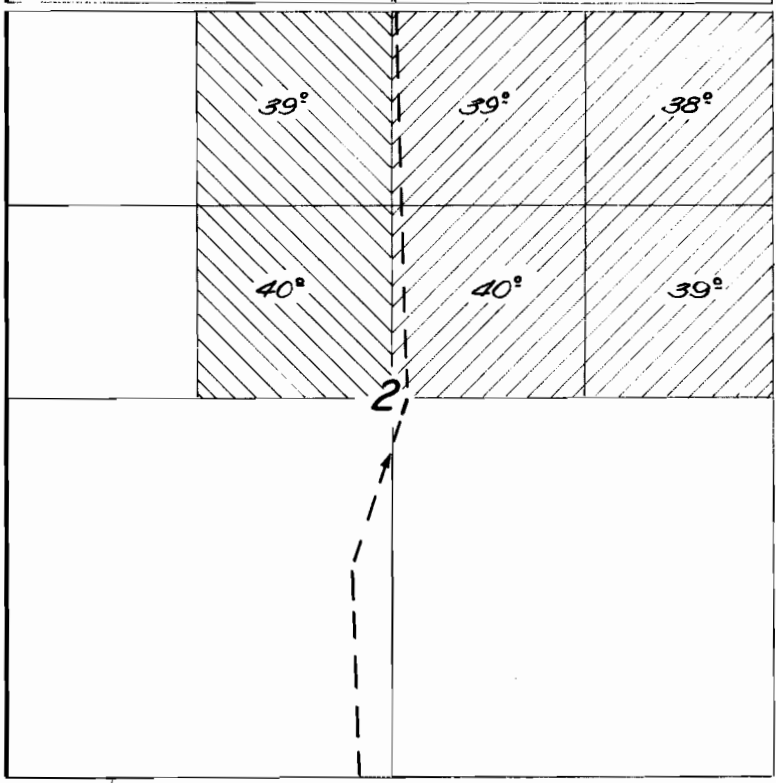

 12  
Well

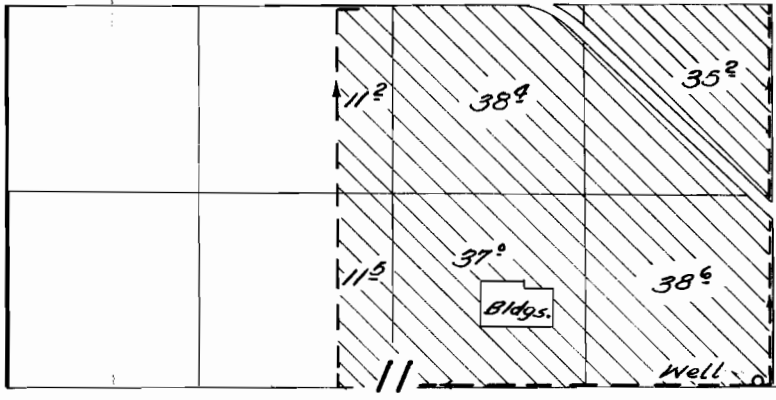

12