


# T. 1S. R. 3W. W.M.

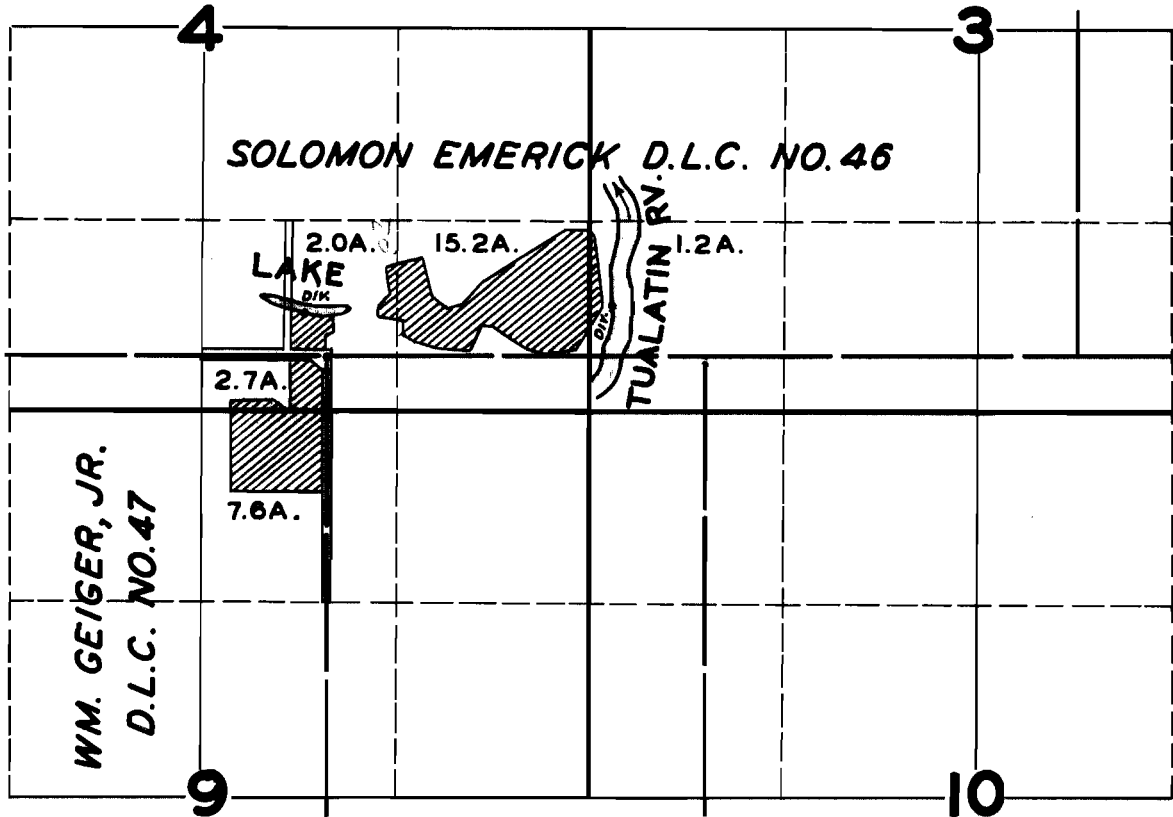

## FINAL PROOF SURVEY UNDER

Application No. 21690 ... Permit No. 17033 ...  
IN NAME OF

D.W. MCBETH

Surveyed MAY 28 1948, by JAS. E. BUNNELL