T.29S. R.4W. W.M.

Sec. 14

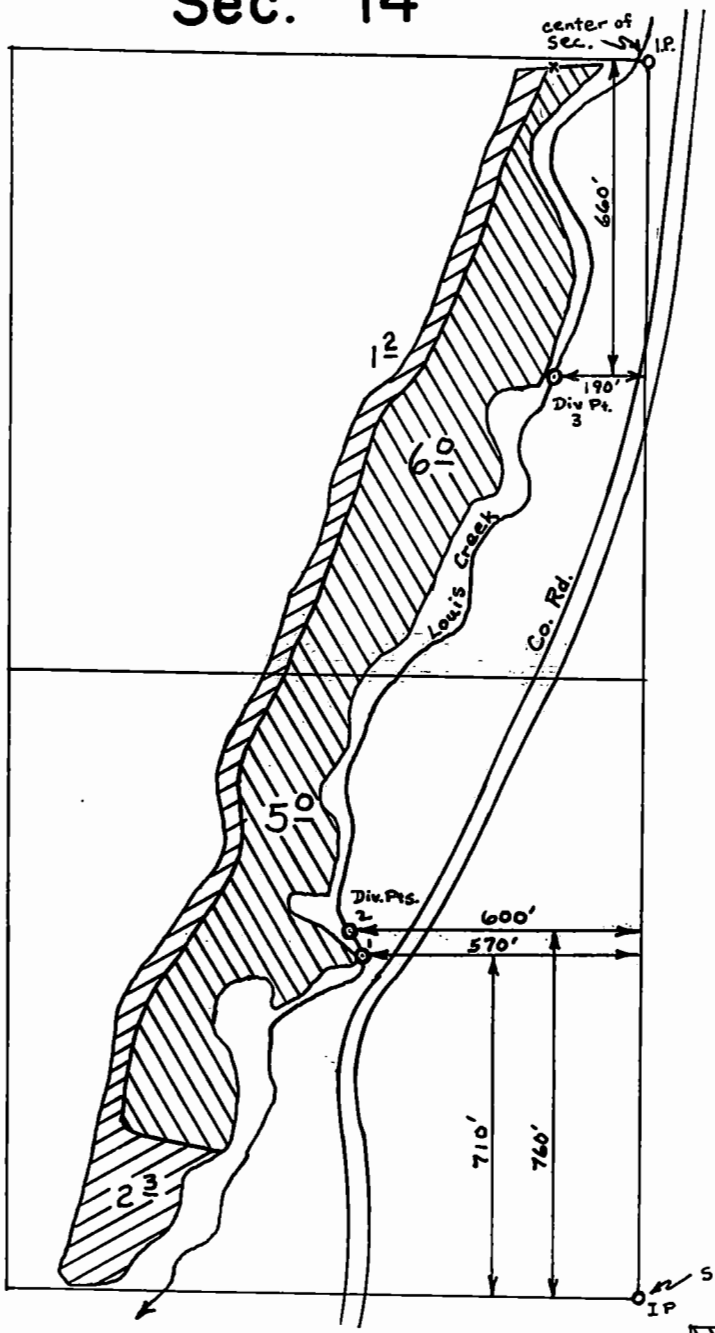

SCALE: 1"= 400'

FINAL PROOF SURVEY
UNDER

Permit # 3544

Permit # 33250

Application No. 44456 **Permit No.** 33250
IN NAME OF

LUTHER H. PRUETT

Surveyed Jan. 20 1978 Nov. 8 1978, **by** D. Sparks S. Donaldson

Doug Co 77-3-48 JSD