


T. 8 S. R. 39 E. W. M.

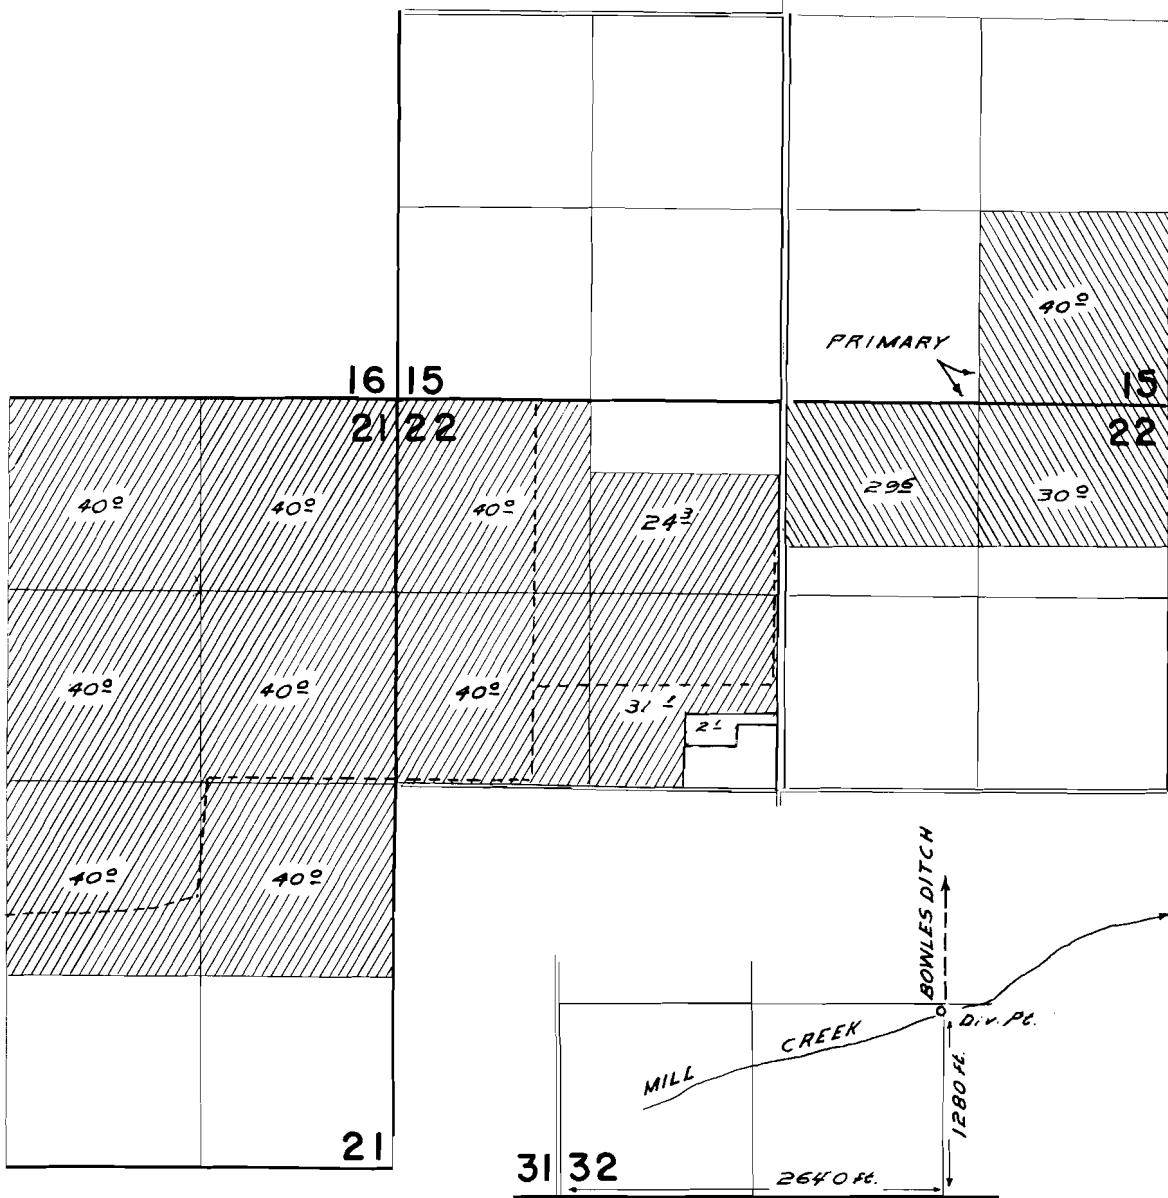

**FINAL PROOF SURVEY**  
UNDER

Application No. 33510... Permit No. 26504  
IN NAME OF

**NORBERT L. SIEG**

Surveyed NOV. 16, 17 1964, by C. GARDNER.