


T. I I S. R. 4 W. W. M.

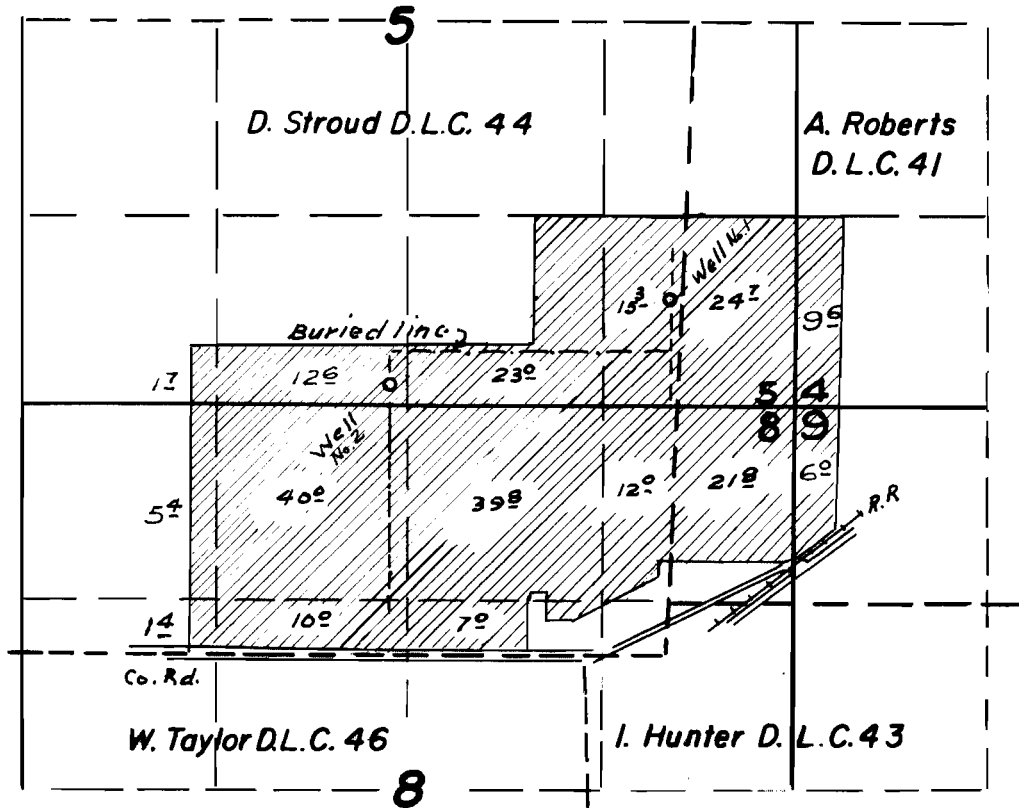

FINAL PROOF SURVEY
UNDER

Application No. G-822 Permit No. G-742
IN NAME OF

Oregon State University

Surveyed July 15, 1964 by Floyd L. Siegmund