


T. 14 S. R. 5 W. W. M.

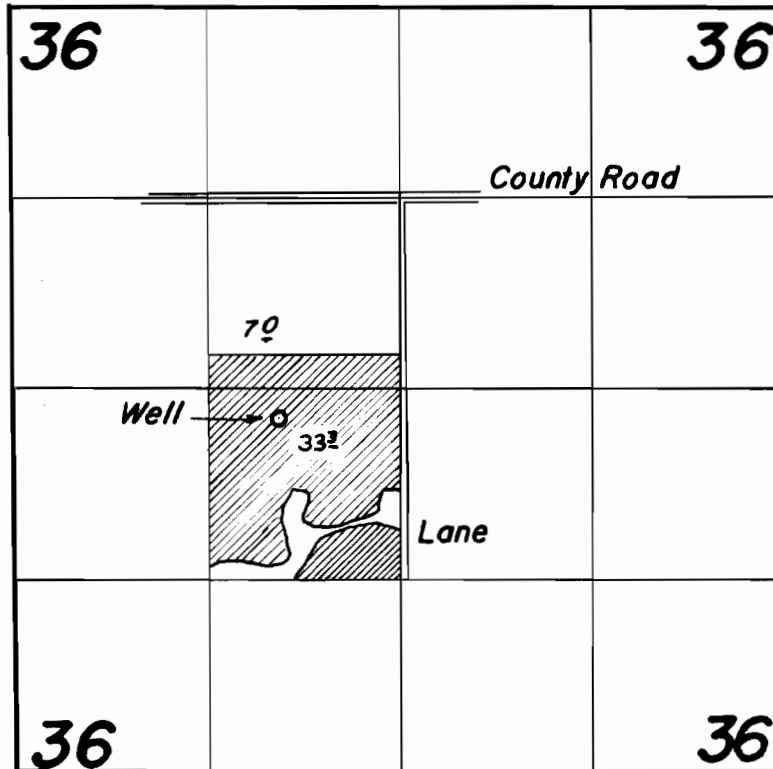

FINAL PROOF SURVEY
UNDER

Application No. G-2369 Permit No. G-2183
IN NAME OF

Gertrude V. Howard Workinger

Surveyed June 13, 1963, by Floyd L. Sigmond
Sept 2, 1965 R. Jackson