T.24&25S.R.12W.W.M.

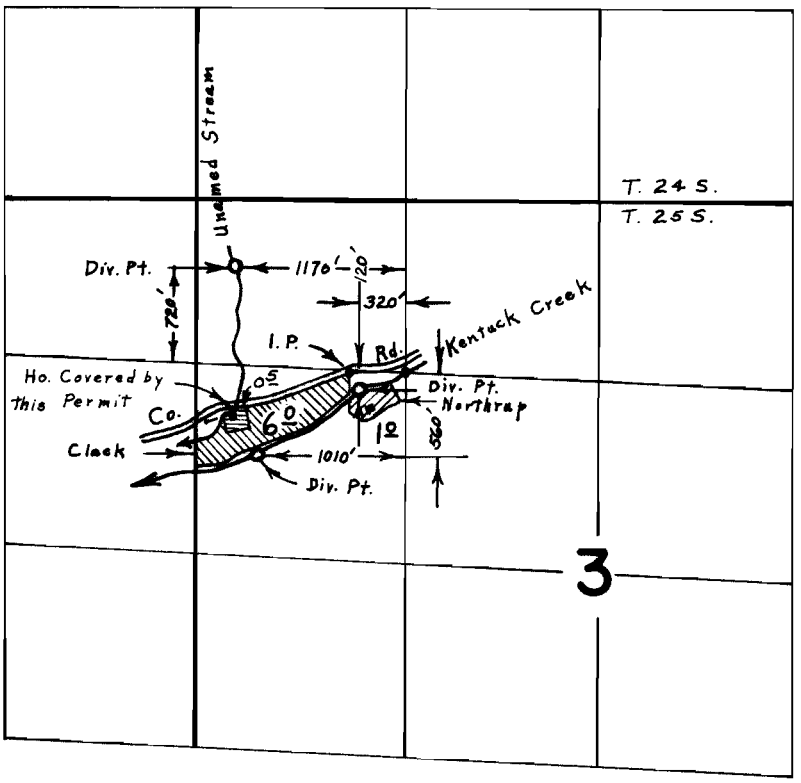

FINAL PROOF SURVEY
UNDER

Application No. 26322 Permit No. 21025
IN NAME OF

ELMER & LEAH CLACK

THERON & KATHRINE NORTHRUP

Surveyed Aug. 2 1961, by C. O. Bartels
Aug. 14 1963, by R. Jackson
Sept. 14 1966 by L. E. Gould

1961-V
1963-L
1966-W