


T.27S.R.12W.W.M.

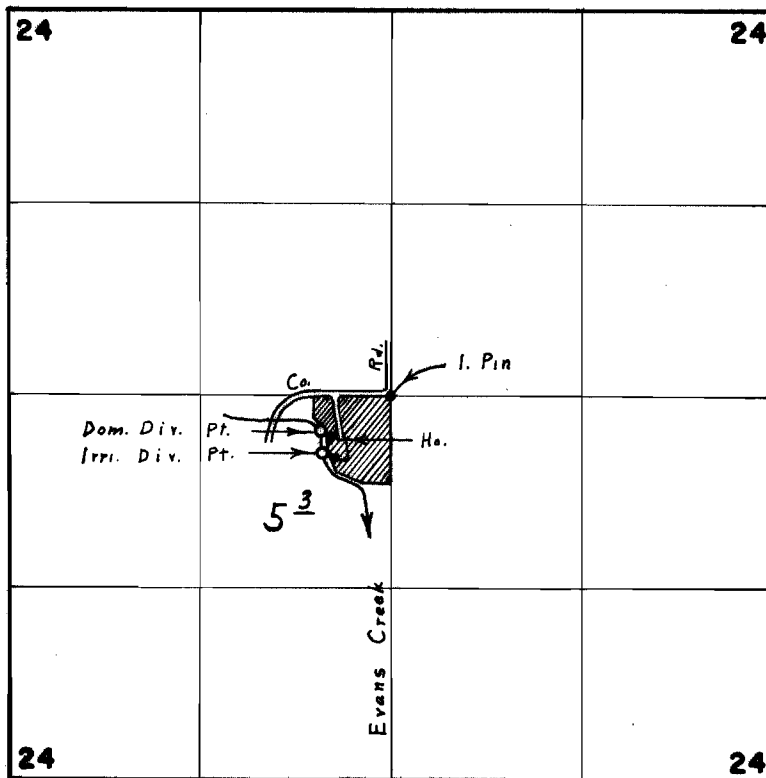

Div. Pts. Located 240' S. & 450' W.; 390' S. & 470' W.

Both from the N.E. Cor., N.E. $\frac{1}{4}$, S.W. $\frac{1}{4}$, Sec. 24

FINAL PROOF SURVEY UNDER

Application No. 39482 Permit No. 29310
IN NAME OF

FRED S. CRAMER

Surveyed Oct. 10, 1966, by L. E. Gould