


T.25S.R.12W.W.M.

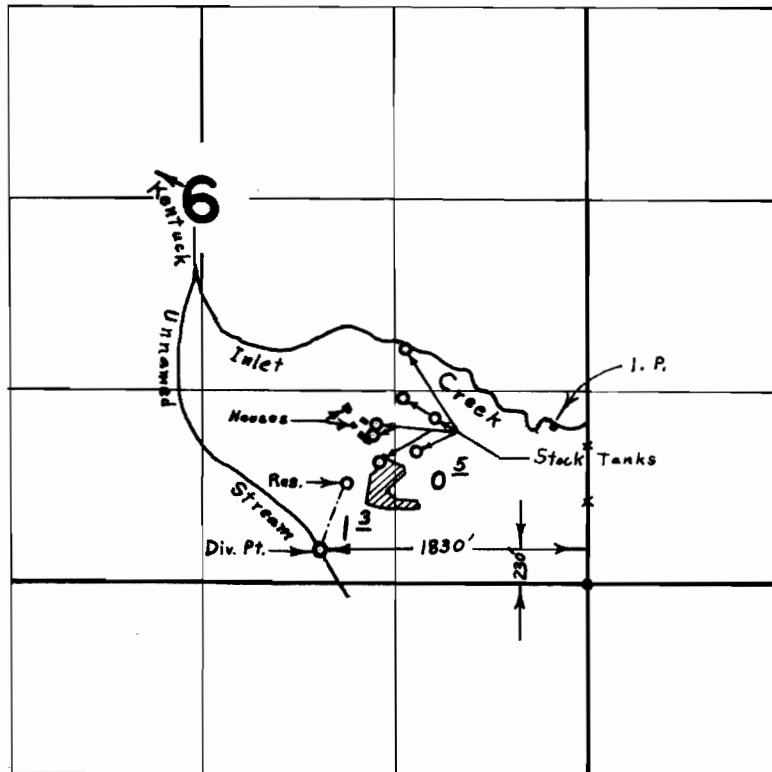

FINAL PROOF SURVEY
UNDER

Application No. 34585 Permit No. 27161
IN NAME OF
C. V. & P. A. FREUDE

Surveyed Sept. 15 1966, by L. E. Gould