


T.27S.R.IIW.W.M.

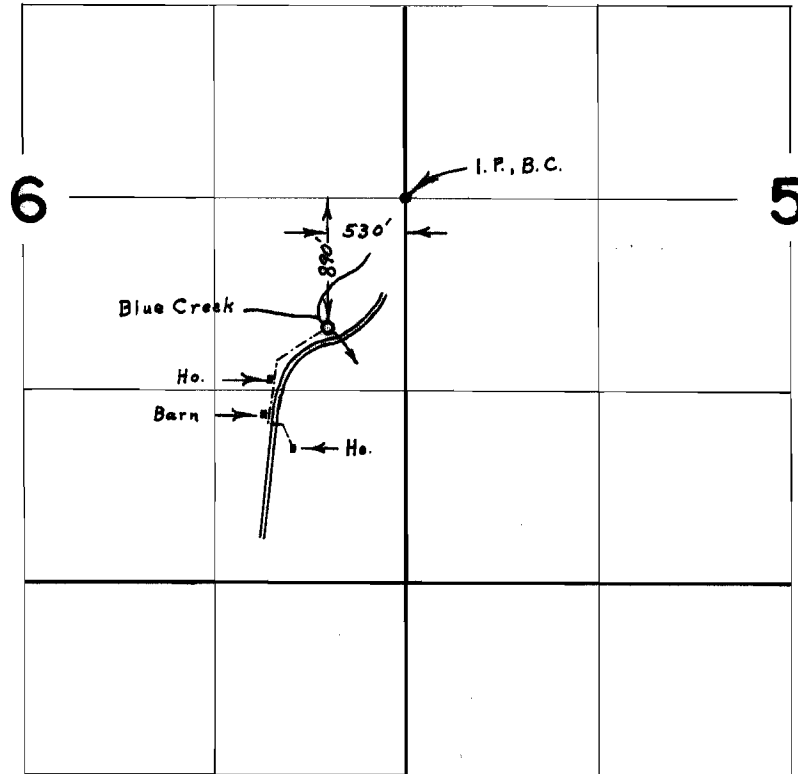

FINAL PROOF SURVEY UNDER

Application No. 39337. Permit No. 29287
IN NAME OF

WINNIE B. PIKE

Surveyed Oct. 7, 1966, by L. E. Gould