


T.26S.R.12W.W.M.

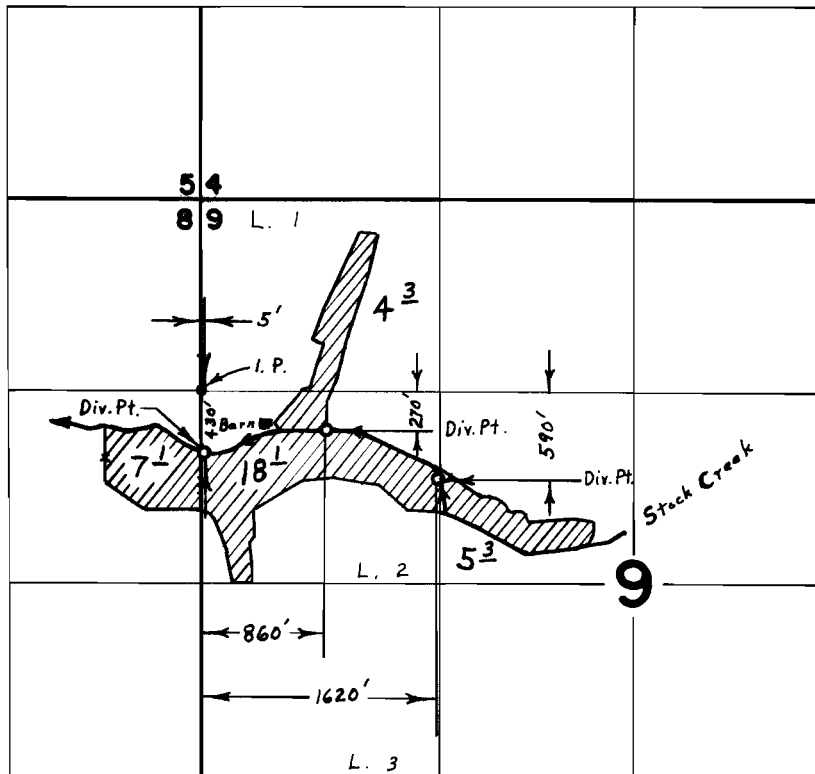

FINAL PROOF SURVEY
UNDER

Application No. 40717 Permit No. 30330
IN NAME OF

GEORGE F. ROSS

Surveyed Oct. 5 1966, by L. E. Gould