


P 28465  
33714

# T.13S.R.30&31E.W.M.

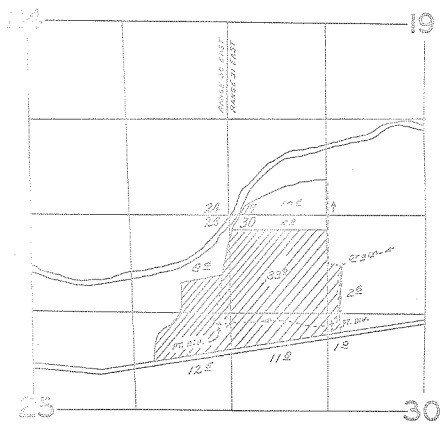

## FINAL PROOF SURVEY UNDER

Application No. 38199... Permit No. 28465...  
IN NAME OF

JOSEPH C. OLIVER

Surveyed 6-25, 1965, by G. Ward