


T.38S.R.4W.W.M.

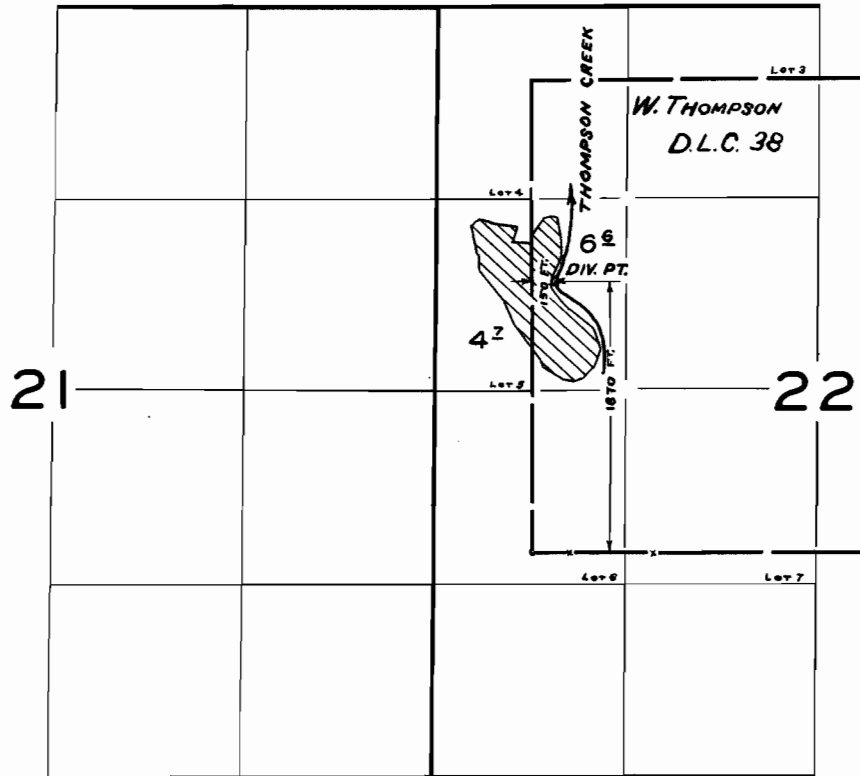

FINAL PROOF SURVEY
UNDER

Application No. 38716 Permit No. 28830
IN NAME OF

THOMAS R. & FLORENCE B. BROWN

Surveyed JUN. 23 1965, by C. GARDNER