


T. 39 S. R. 2 W. W. M.

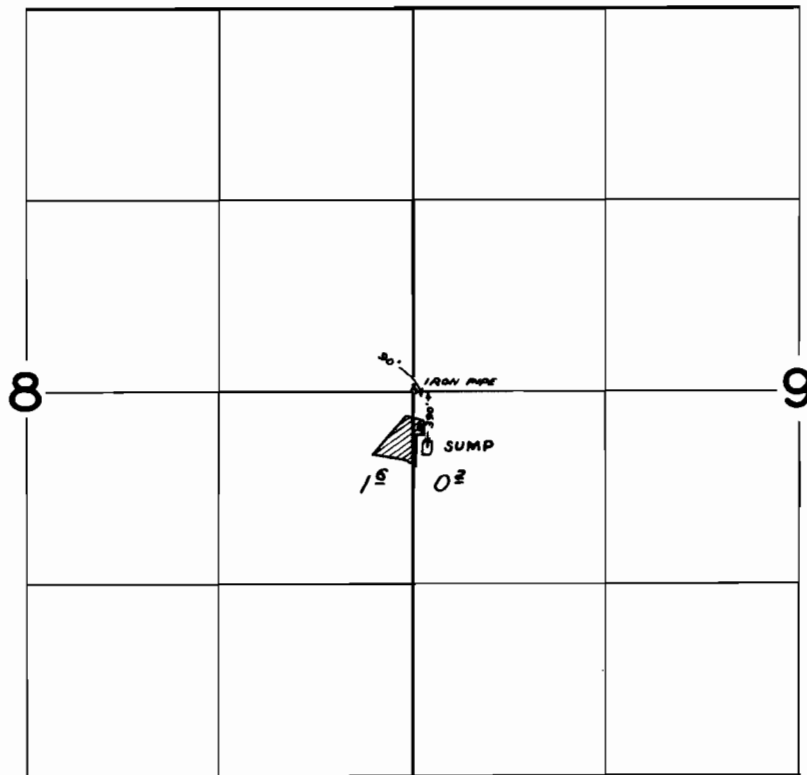

FINAL PROOF SURVEY
UNDER

Application No. G-1833 Permit No. G-1679
IN NAME OF

MRS. DOLLY DE VOS

Surveyed JUL. 1 1965, by C. GARDNER