


T. 38 S. R. 2 W. W.M.

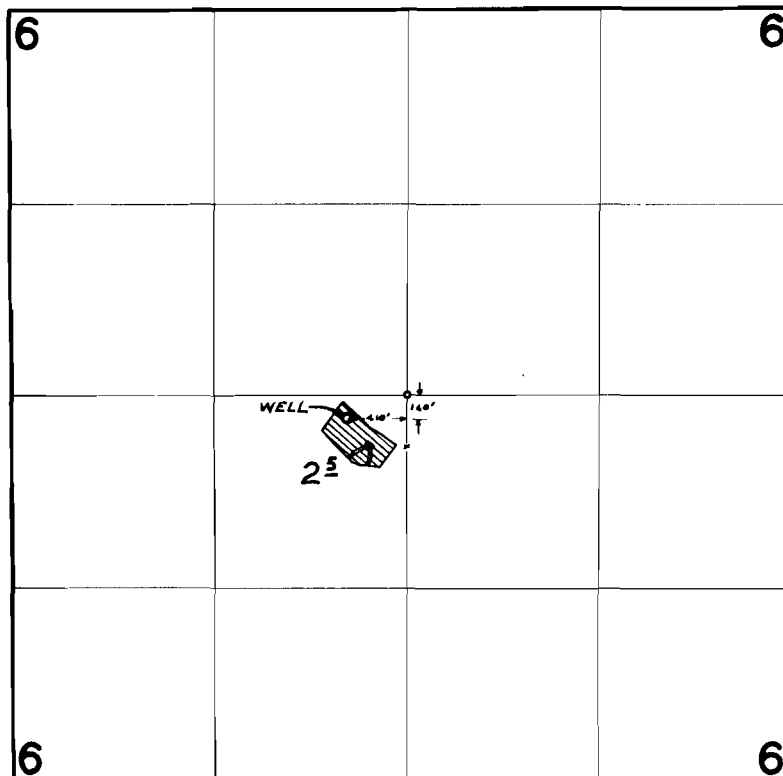

FINAL PROOF SURVEY
UNDER

Application No. G-1865 Permit No. G-1707
IN NAME OF

O. L. DEWEY

Surveyed JUN. 22 1965, by C. GARDNER