


T.37&38 S.R.4 W.W.M.

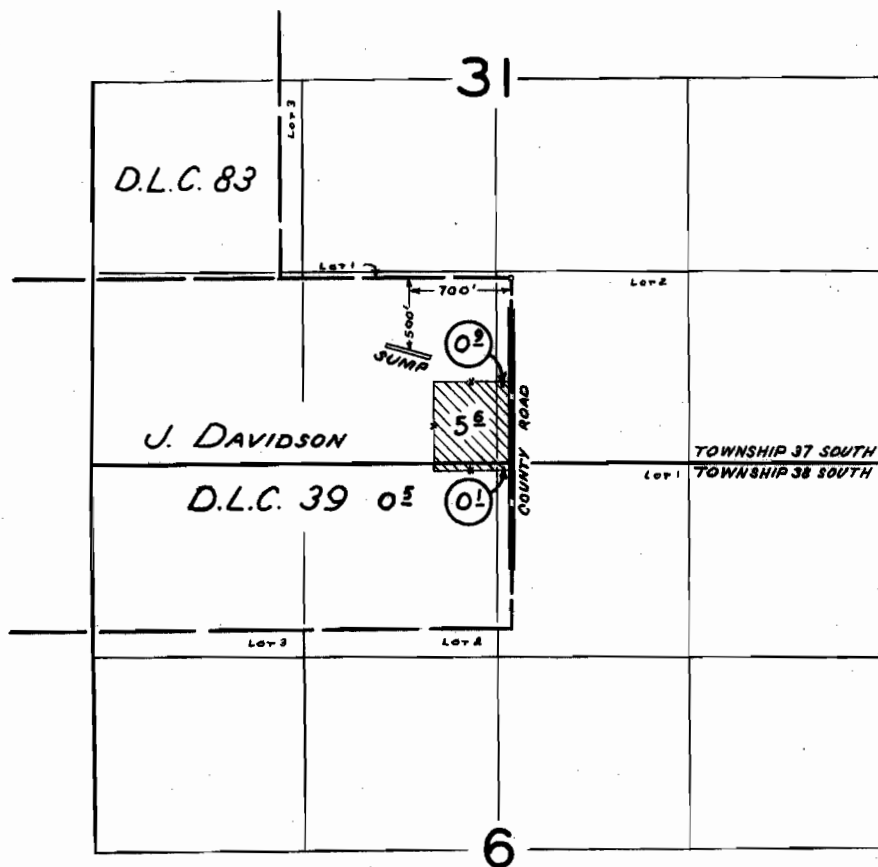

FINAL PROOF SURVEY
UNDER

Application No. G-1661 Permit No. G-1703
IN NAME OF

DAVID W & VIRGINIA M. FROMME

Surveyed JUN 28 1965, by C. GARDNER