


T. 33S.R. 2E.W.M.

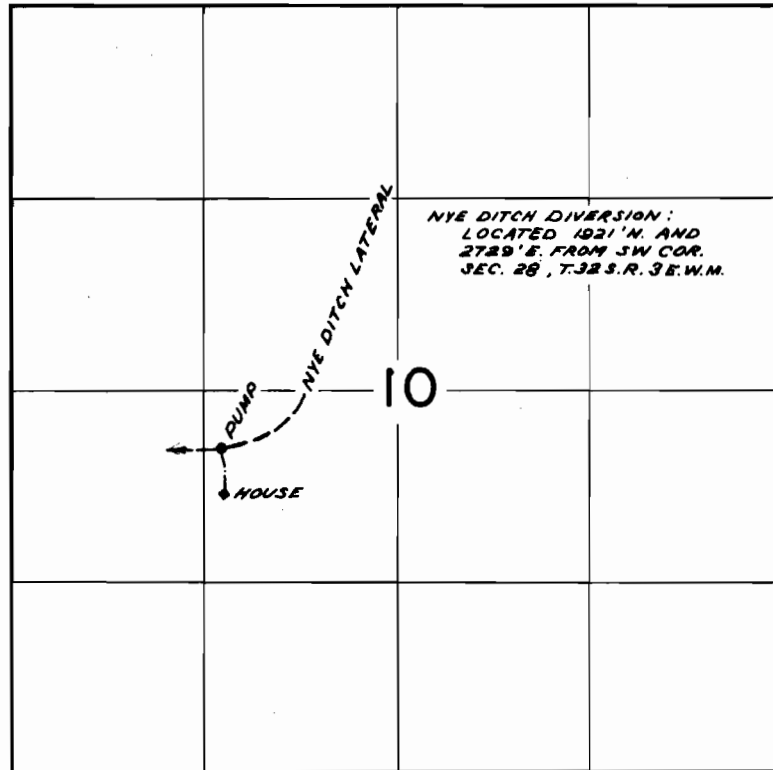

**FINAL PROOF SURVEY**  
UNDER

Application No. 33772 Permit No. 26664  
IN NAME OF

F. EVERETT SHAFER

Surveyed JUL. 22. 1965. by C. GARDNER