


T.35S.R.1W.W.M.

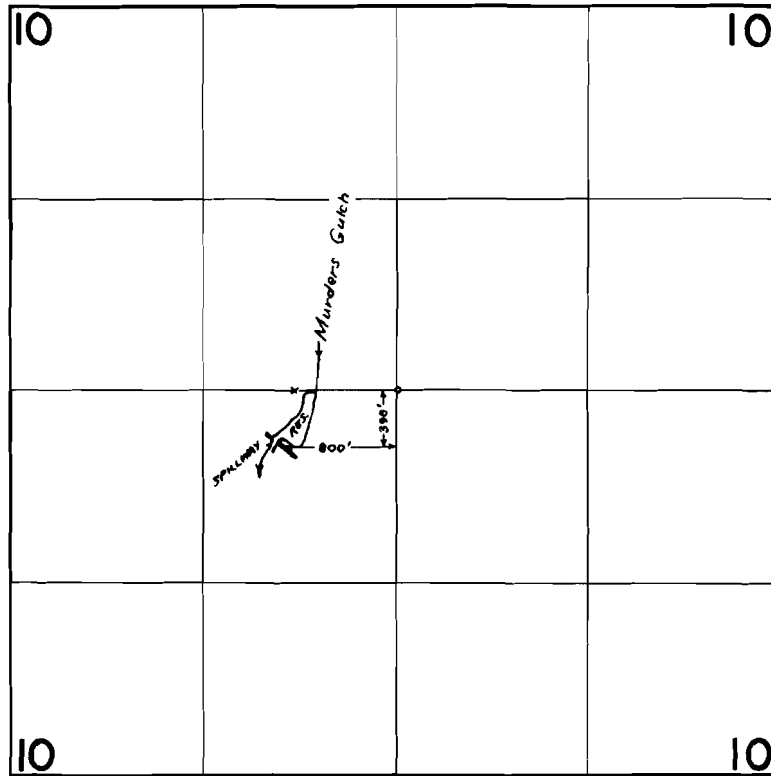

FINAL PROOF SURVEY
UNDER

Application No. R-39077 Permit No. R-3869

IN NAME OF

HOWARD F. AND/OR ANN TODD

Surveyed JUL 13 1965, by C. GARDNER