


Twp 40S

R8WWM

Application Map to appropriate the Public Waters  
of the State of Oregon

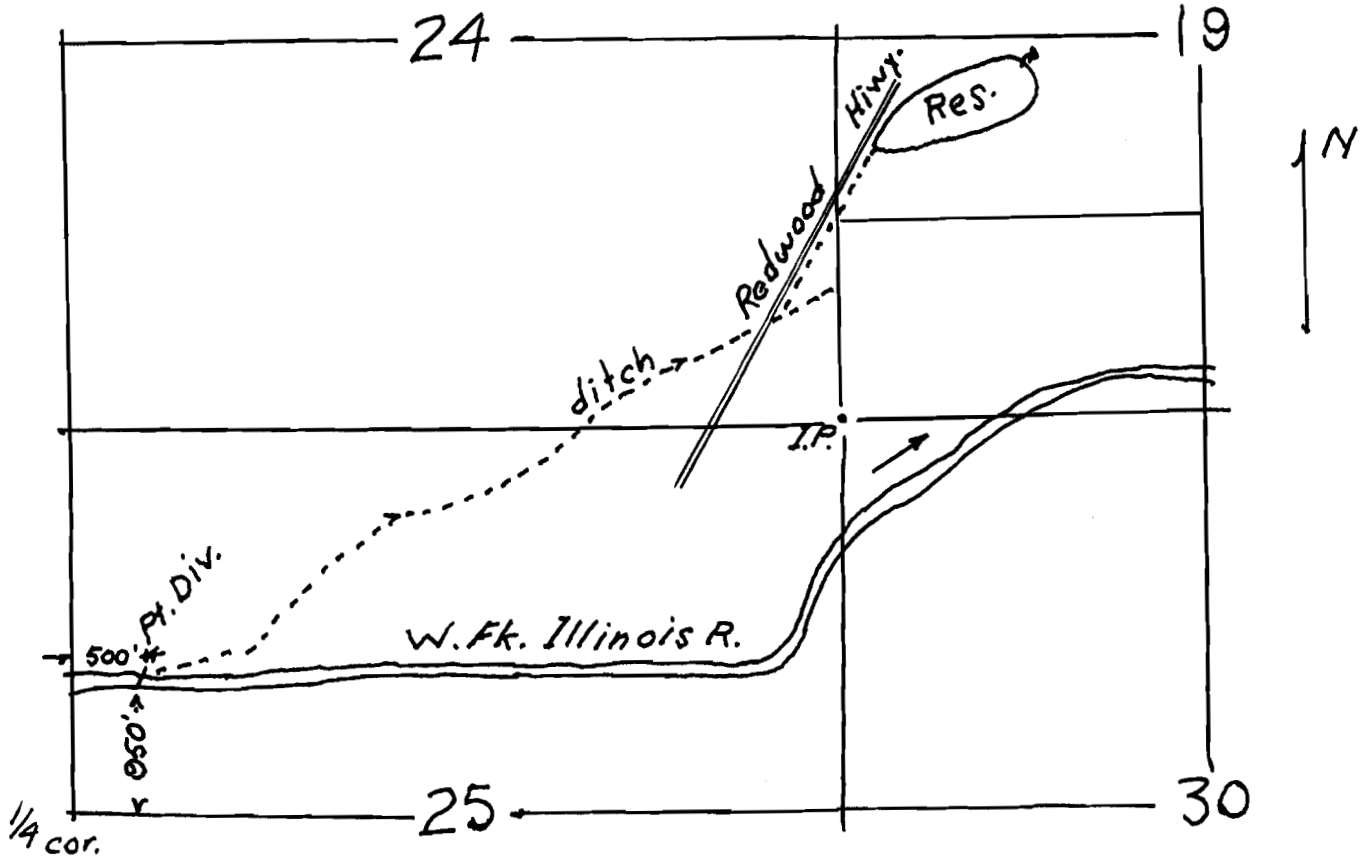

Charlie A. Trefethen

P.O. Box 591 Cave Junction  
Oregon

Scale: 4" = 1 mile

Oct. '64

Application No. 40417  
Permit No. 30133