


T.36S.R.6W.W.M.

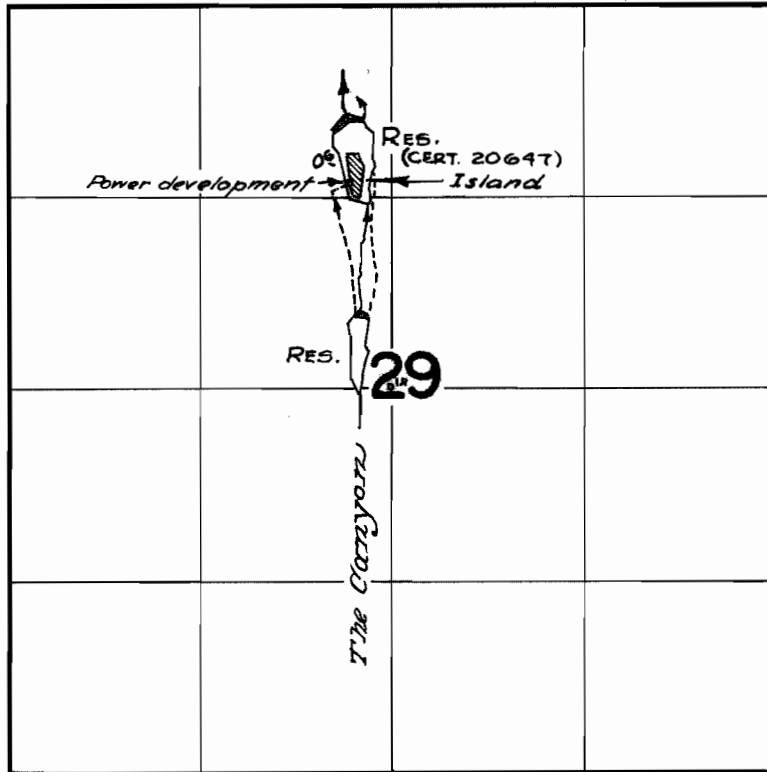

FINAL PROOF SURVEY
UNDER

R-38911 R-3865
Application No. 39133..... Permit No. 29181.....
IN NAME OF

C. VERN WHITE

Surveyed June 26, 1965, by *R. Jackson*