


T36S. R.14E. W.M.

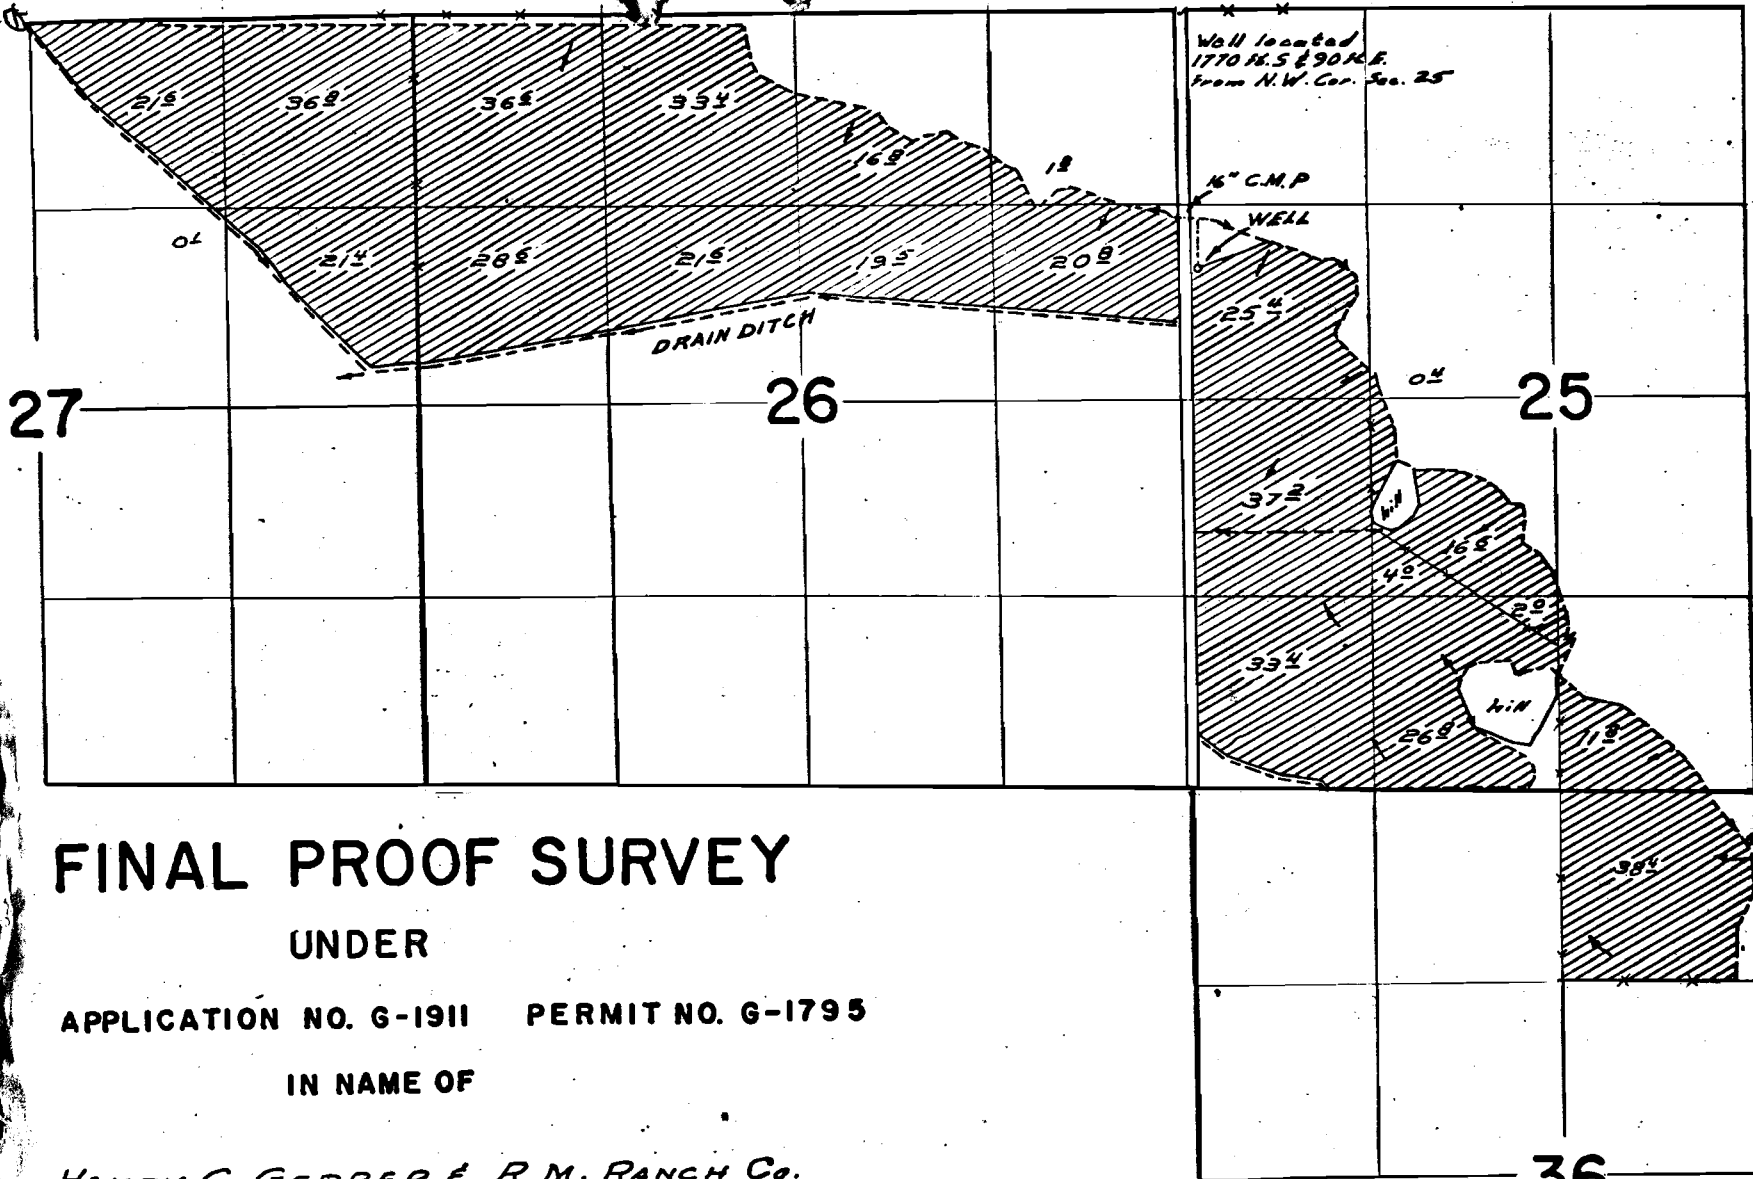

# FINAL PROOF SURVEY

UNDER

APPLICATION NO. G-1911 PERMIT NO. G-1795

IN NAME OF

HENRY C. GERBER & R.M. RANCH Co.

SURVEYED OCT. 26 & 28 BY W.J. Ruppert  
1966

S. J. Sprague, R. M. Wells

G-1795  
399210