


T. 39 S. R. 10 E. W. M

East R. Mac.

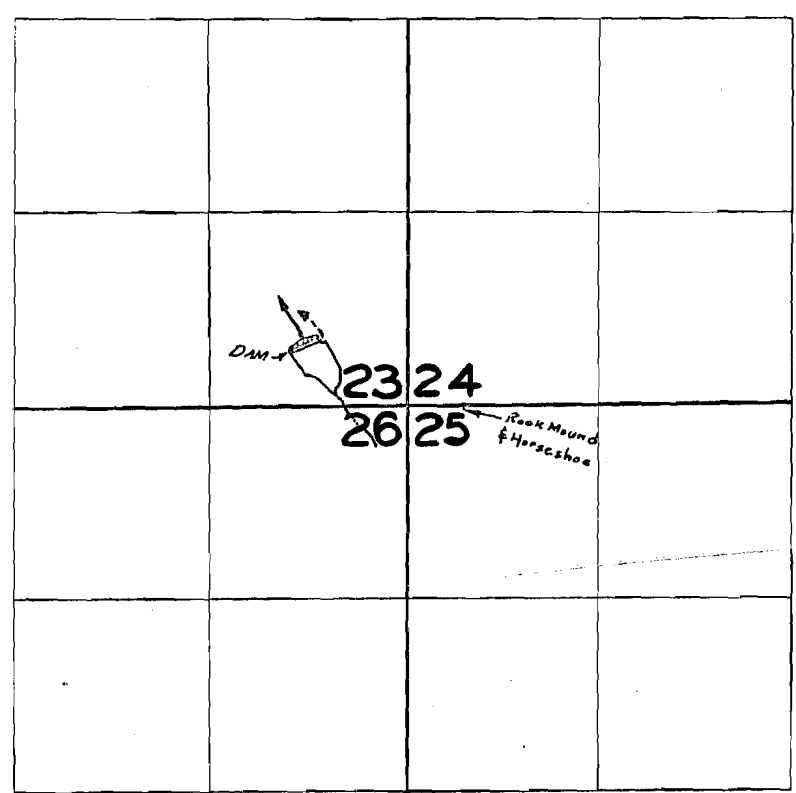

FINAL PROOF SURVEY UNDER

Application No. R-37110 Permit No. R-2717
IN NAME OF

TAYLOR E. HIGH

Surveyed JUL 23 1964 by R. JACKSON