


T.18S.R.6W.W.M.

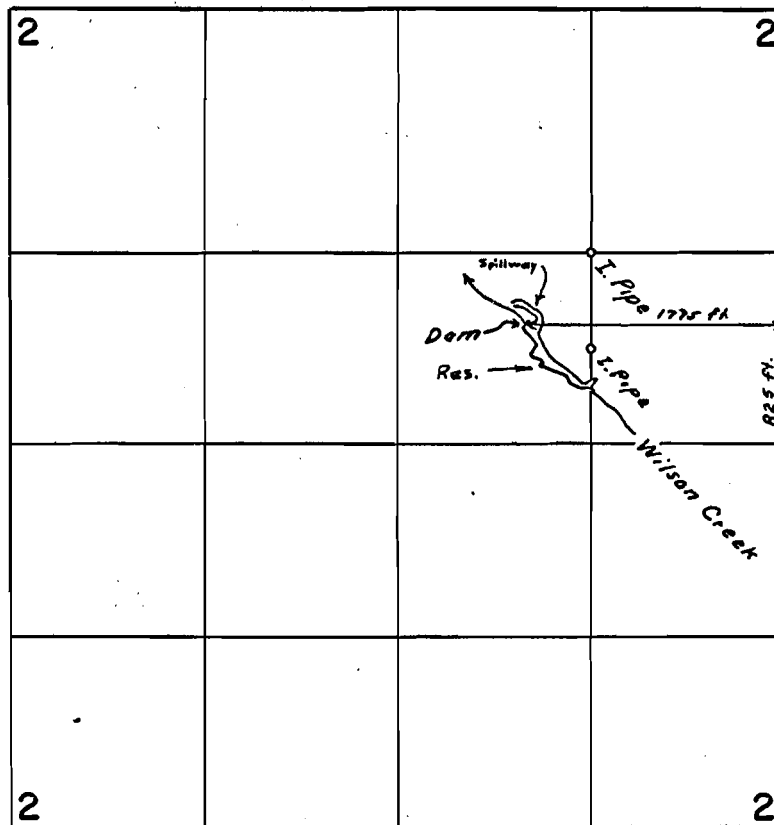

FINAL PROOF SURVEY
UNDER

34603 27171
Application No. ~~R-34424~~ Permit No. ~~R-2584~~
IN NAME OF

CAMP FIRE GIRLS

Surveyed April 29, 1965, by *Clayton J. Gardner*