


T.17S.R.6W. W.M.

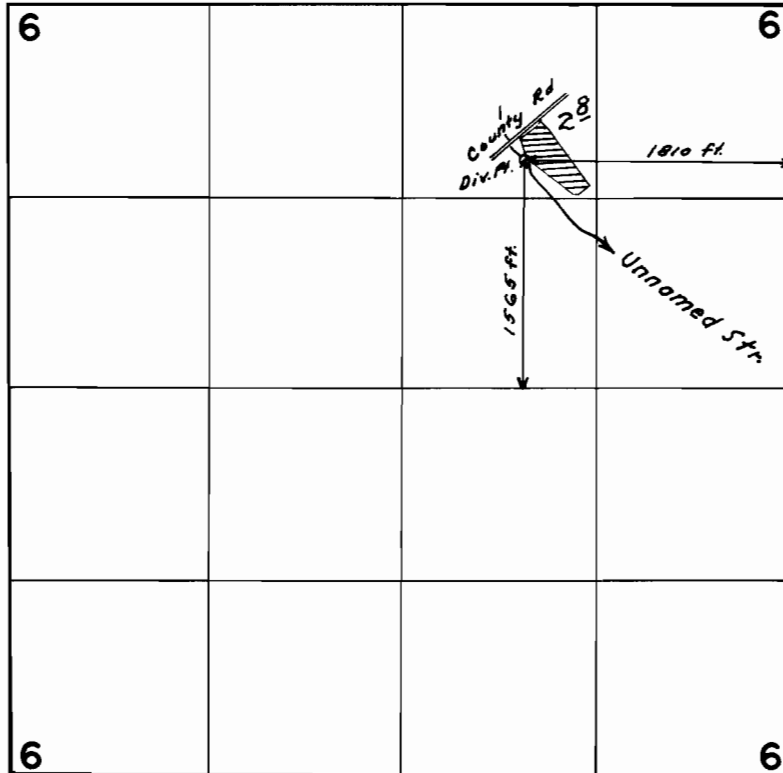

FINAL PROOF SURVEY UNDER

Application No. 38187 Permit No. 28461
IN NAME OF

HILMER C. CHRISTIANSEN

Surveyed May 5, 1965, by Clayton J. Gardner