


T.17S.R.6W.W.M.

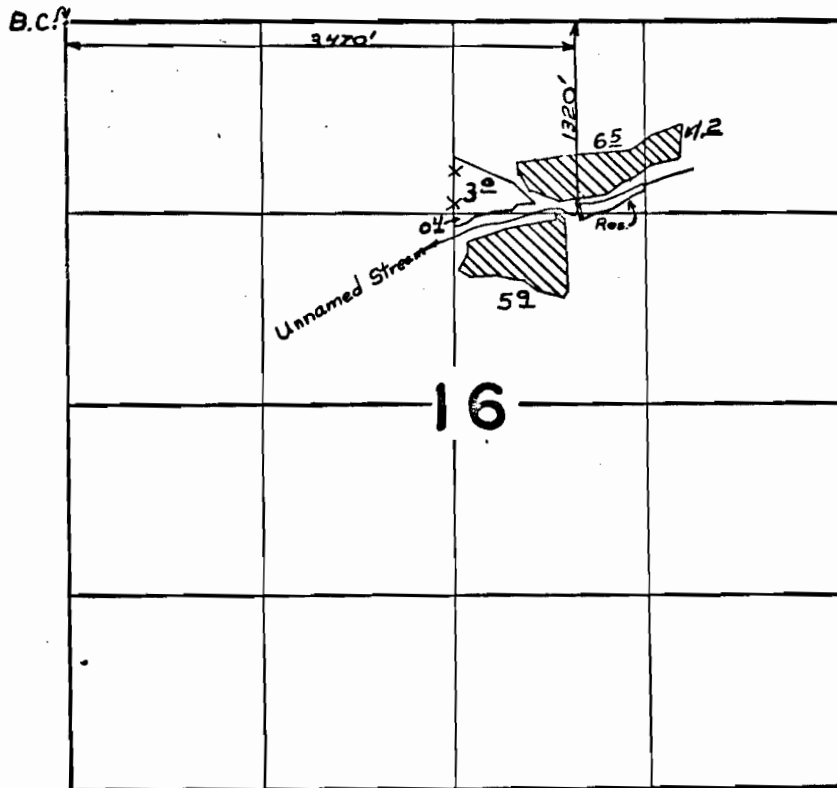

FINAL PROOF SURVEY
UNDER

Application No. ^{R-29418} 29419..... Permit No. ^{R-2319} 26538.....
IN NAME OF

.....WILLIAM E. DAVIS.....

Surveyed Mar. 22+23 1967, by W. U. Ruppert.....