


T. 16 S. R. 4 W. W.M.

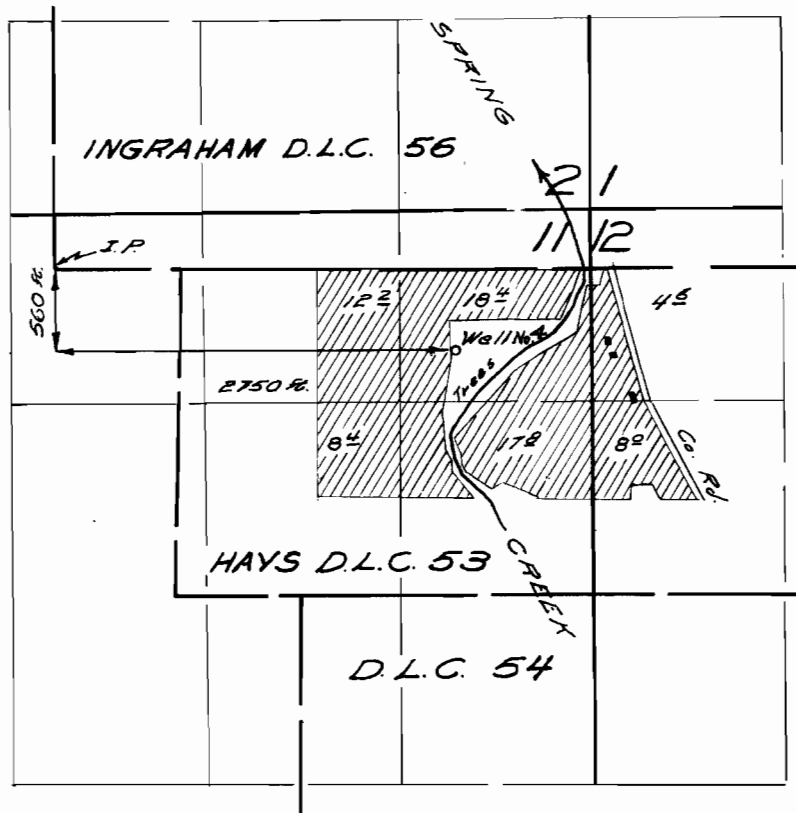

FINAL PROOF SURVEY
UNDER

Application No. G-2347 Permit No. G-2162
IN NAME OF

RALPH DETERING

Surveyed March 24 1967, by W. J. Pappert