


T.18S.R.5W.W.M.

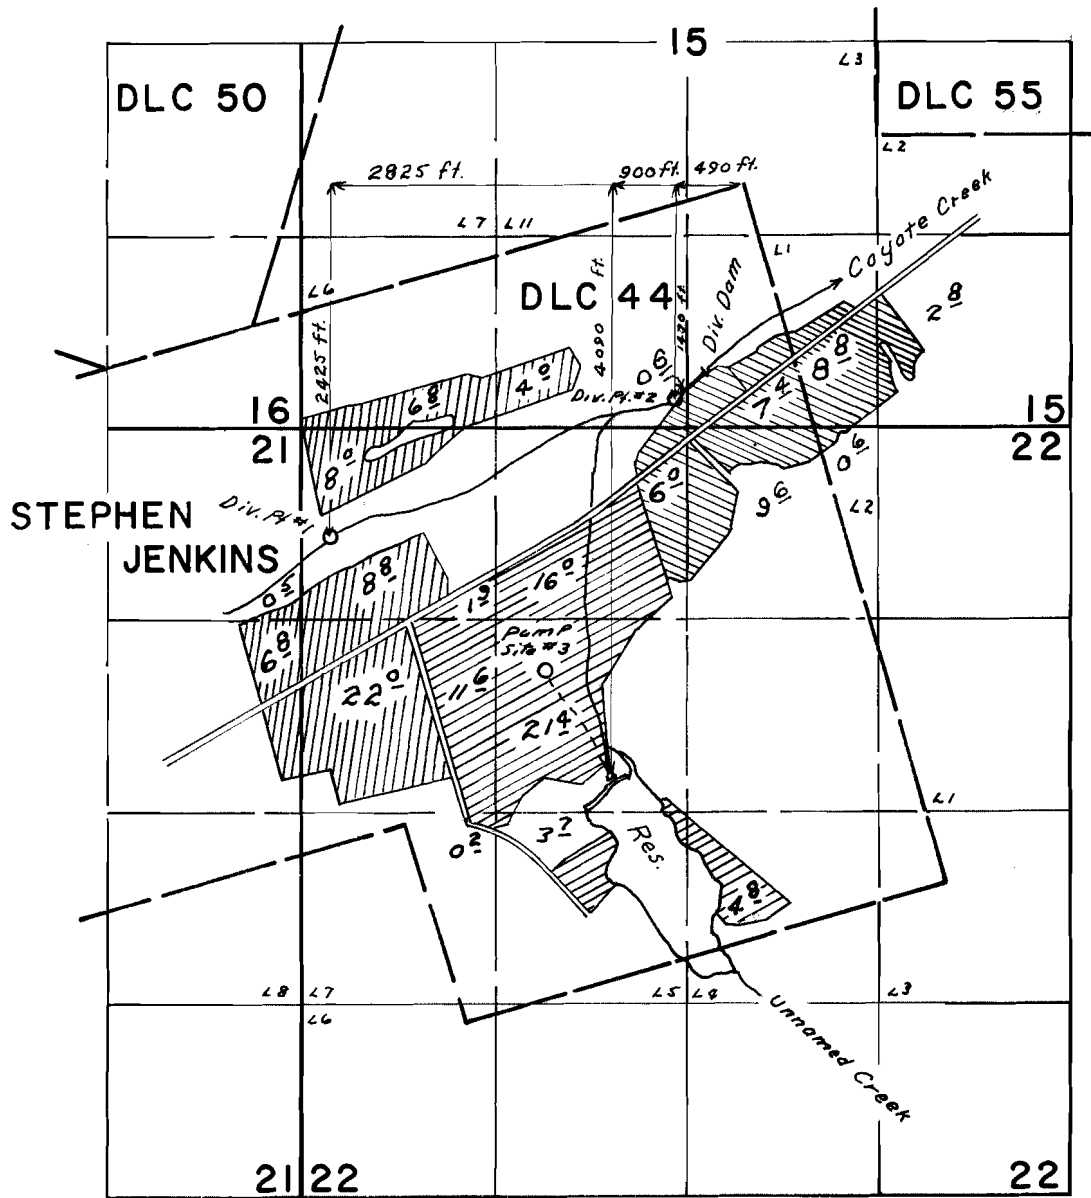

FINAL PROOF SURVEY UNDER

R-27753 R-1516
 Application No. 27754 Permit No. 22424

IN NAME OF
STEPHEN H. FORD

Surveyed April 26, 27, 1965, by *Clayton J. Gordon*