


# T.18S.R.5W.W.M.

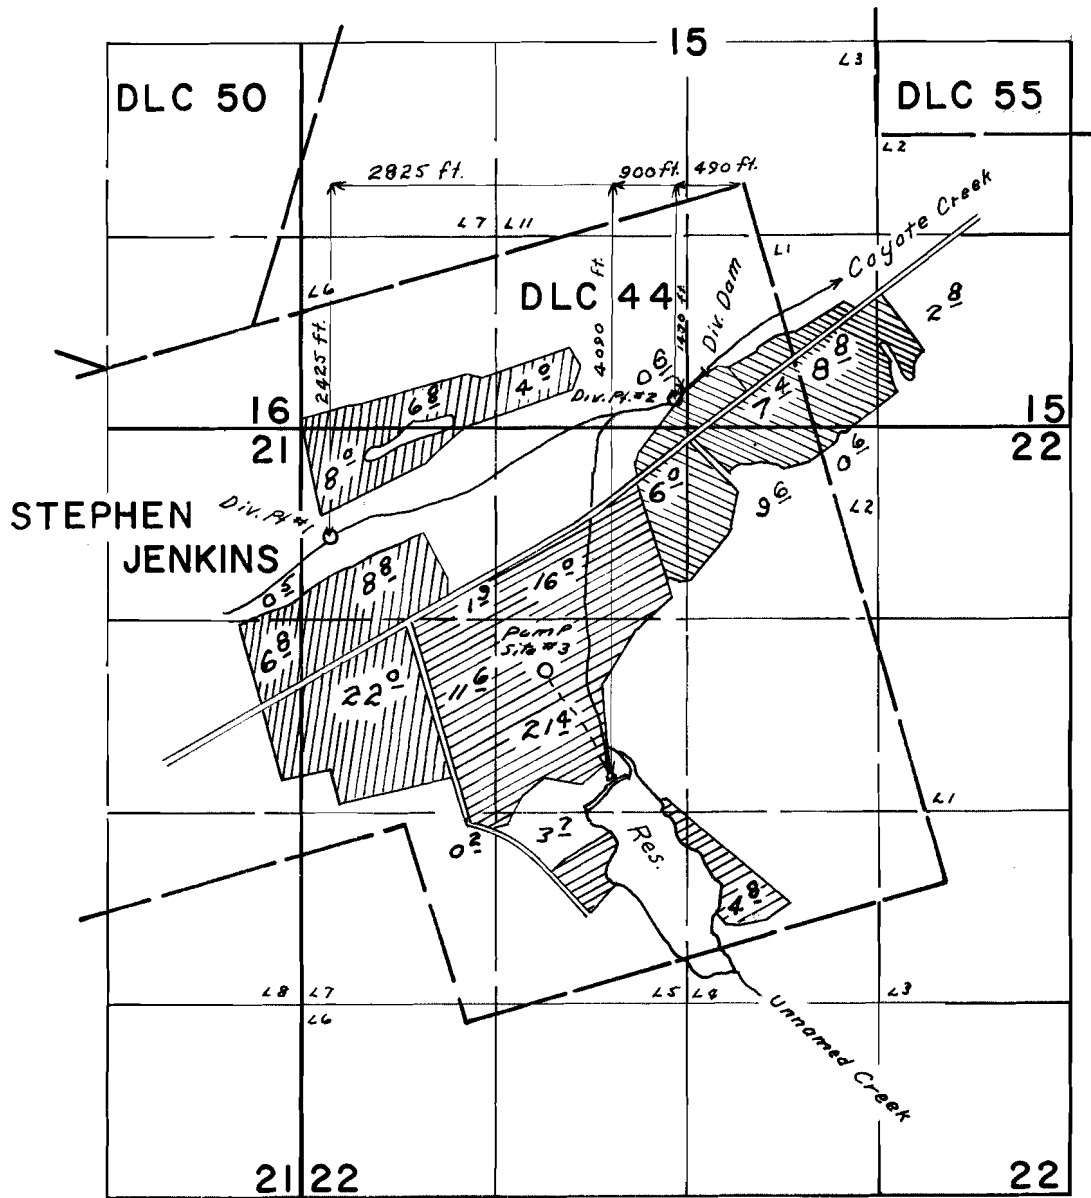

## FINAL PROOF SURVEY UNDER

R-27753                      R-1516  
Application No. 27754      Permit No. 22424

IN NAME OF  
**STEPHEN H. FORD**

Surveyed April 26, 27, 1965, by *Clayton J. Gardner*