


# T.15S. R. 4 W. W.M.

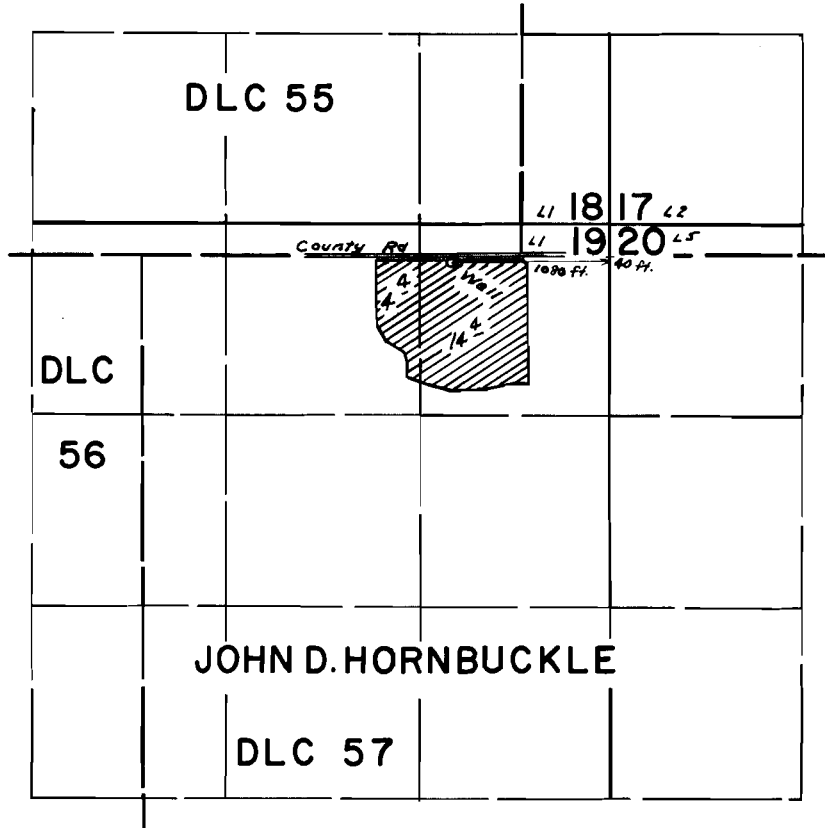

## FINAL PROOF SURVEY UNDER

Application No. G-2020 Permit No. G-1859  
IN NAME OF  
**BERNARD GLENN**

Surveyed May 3, 1965, by *Clayton J. Hardman*