


T.15S. R.4W. W.M.

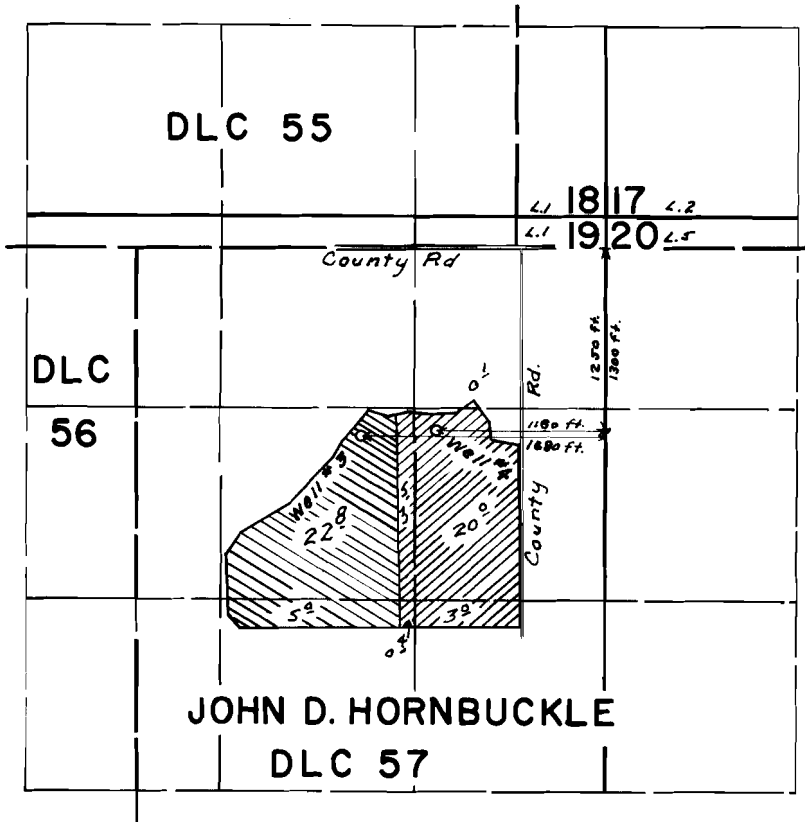

FINAL PROOF SURVEY UNDER

Application No. G-2859, Permit No. G-2660.

IN NAME OF

BERNARD GLENN

Surveyed May 3, 1965, by *Clayton Gardner*