


T.17S.R.7W.W.M.

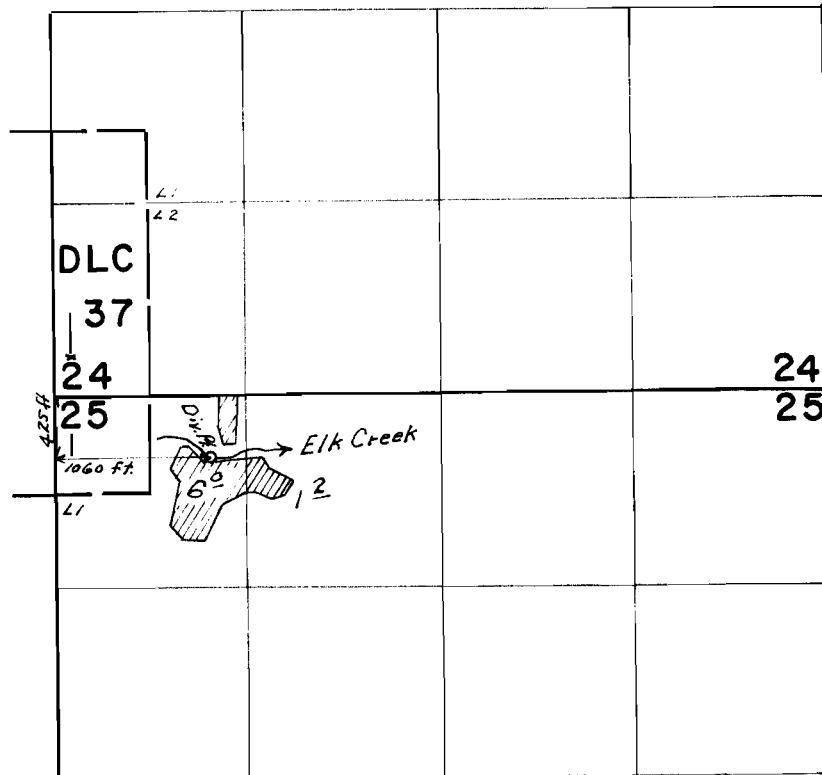

FINAL PROOF SURVEY
UNDER

Application No. 37039 Permit No. 27615
IN NAME OF

WALTER R. MILLER

Surveyed May 5, 1965, by *Rayford Gordon*