


T.15S.R.5W.W.M.

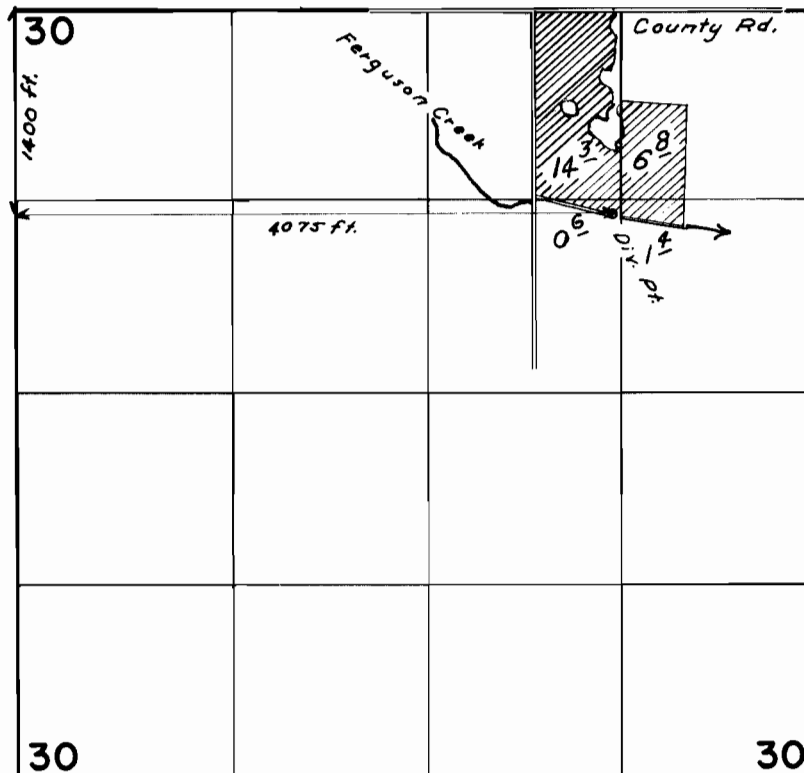

FINAL PROOF SURVEY
UNDER

Application No. 37086 Permit No. 27654
IN NAME OF
DAVID KEITH NULF

Surveyed April 30, 1965 by Clayton Anderson