


T.16S.R.6W. W.M.

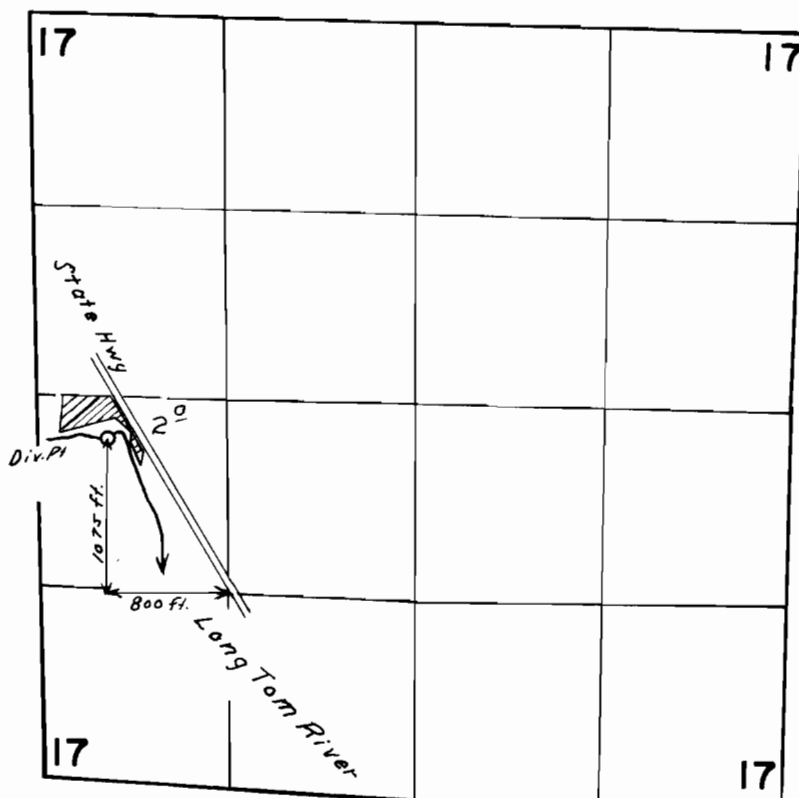

FINAL PROOF SURVEY
UNDER

Application No. 37550 Permit No. 27980
IN NAME OF

SAMUEL EMERY WATSON

Surveyed April 29, 1965, by Clayton J. Gardner