


T.16S.R.4W.W.M.

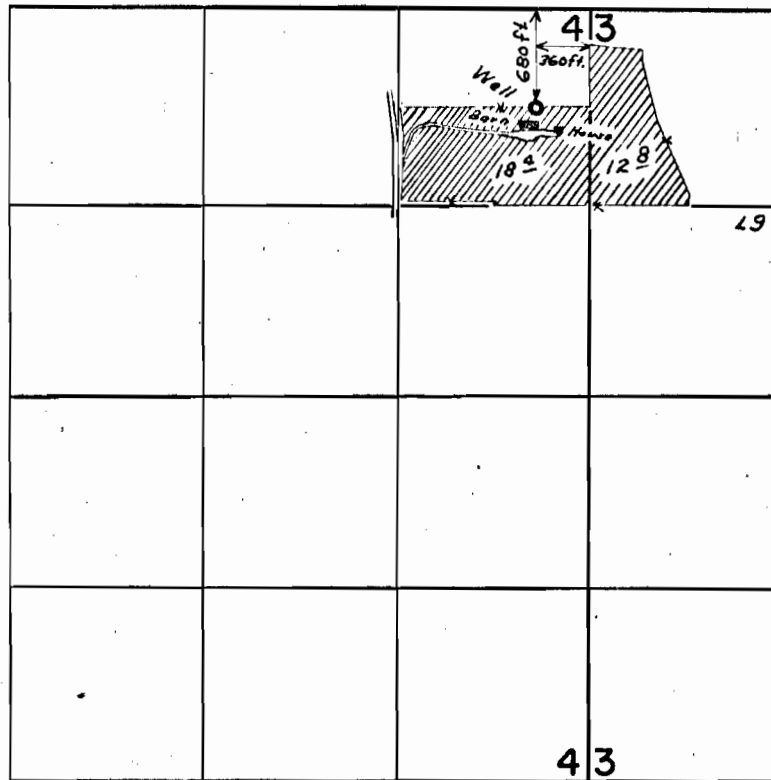

FINAL PROOF SURVEY
UNDER

Application No. G-2843. Permit No. G-2638.

IN NAME OF
GRACE WITHROW or
.....The Estate of **VERNE WITHROW**

Surveyed May 4, 1965, by *Clayton J. Anderson*