


T.9S.R.3E.W.M.

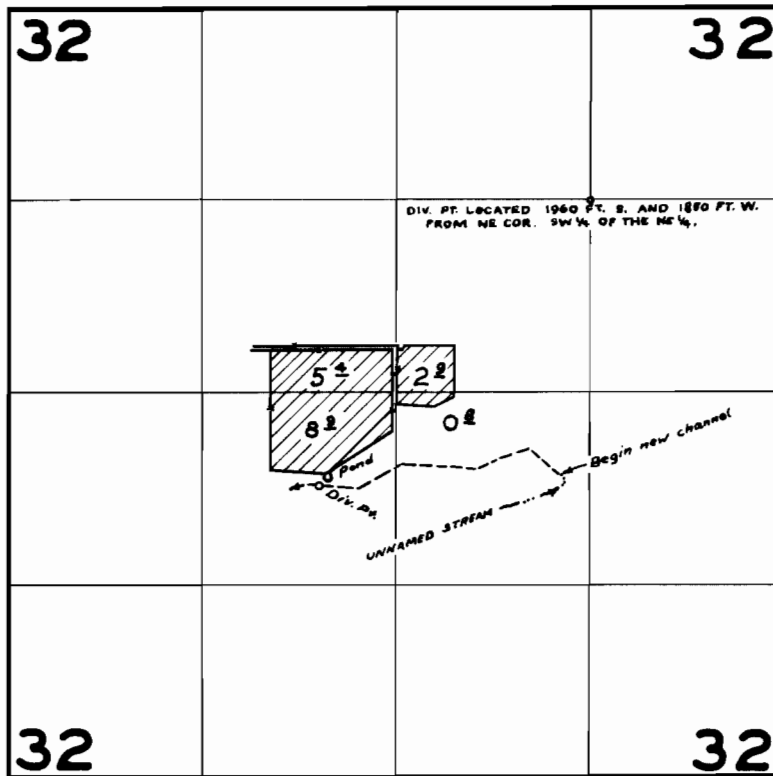

**FINAL PROOF SURVEY**  
UNDER

Application No. 39202 Permit No. 29151  
IN NAME OF

QUINCY V. & VIRGINIA A. MILLER

Surveyed Oct 15 1965, by R. JACKSON