


# T.10S.R.1W.W.M.

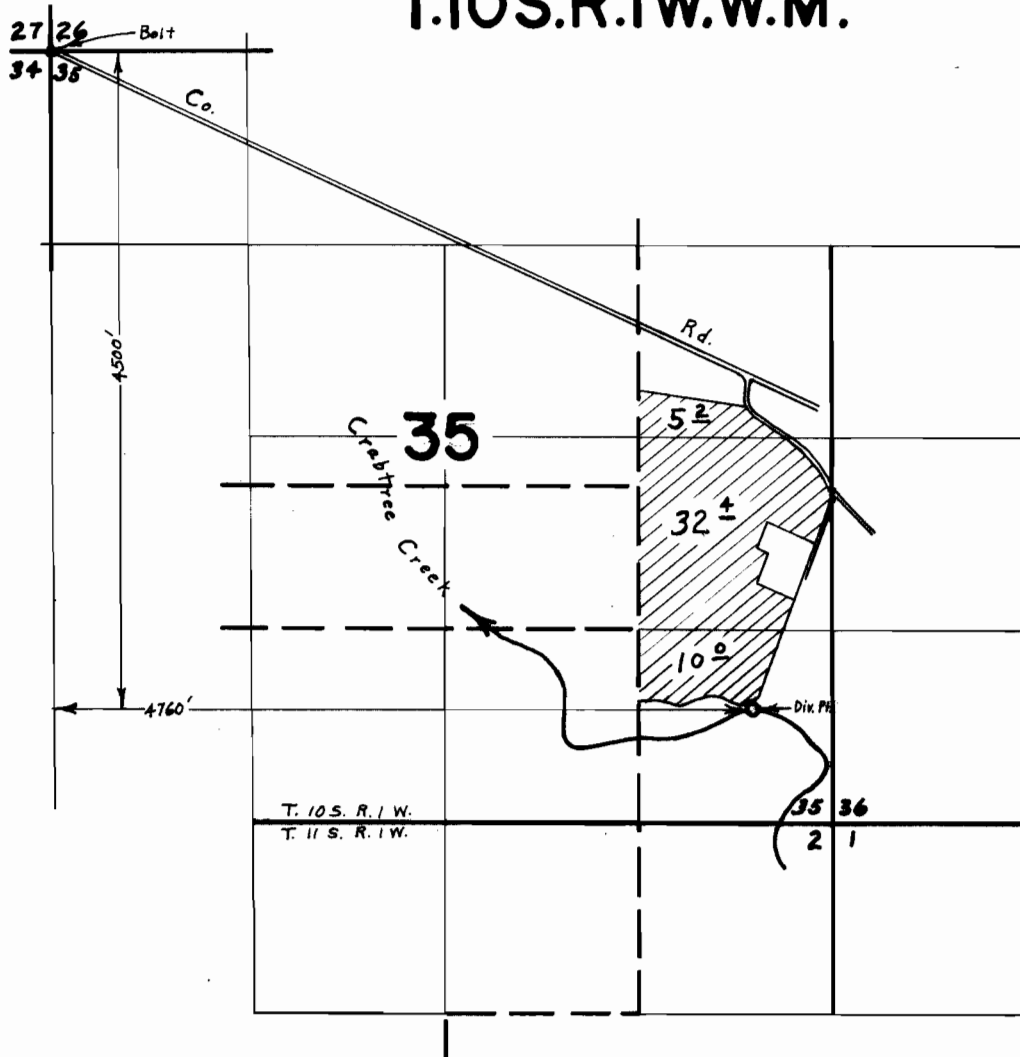

## FINAL PROOF SURVEY UNDER

Application No. 38243 Permit No. 28489  
IN NAME OF  
**WILLIAM YOUNG**

Surveyed May 2, 1966, by L. E. Gould